


OREGON GOLF COURSE T 3 S , R 1 E , WILLAMETTE MERIDIAN CLACKAMAS COUNTY, OREGON


SECTION	LOCATION	ACREAGE OF IRRIGATION
10	SE 1/4 SW 1/4	10.0
	NW 1/4 SW 1/4	1.0
	NE 1/4 SW 1/4	20.0
	SW 1/4 SE 1/4	2.0
	NW 1/4 SE 1/4	10.0
	SE 1/4 NW 1/4	17.0
	NW 1/4 NW 1/4	20.0
	NE 1/4 NW 1/4	20.0
	SW 1/4 NW 1/4	3.0
	SW 1/4 NE 1/4	23.0
3	NW 1/4 NE 1/4	10.0
	NE 1/4 NE 1/4	5.0
	SE 1/4 SE 1/4	22.0
	SW 1/4 SW 1/4	8.0
	SW 1/4 SE 1/4	27.0
	NE 1/4 SE 1/4	4.0
	NW 1/4 SE 1/4	4.0
	SE 1/4 SW 1/4	14.0
	NE 1/4 SW 1/4	12.0
	TOTAL	232.0

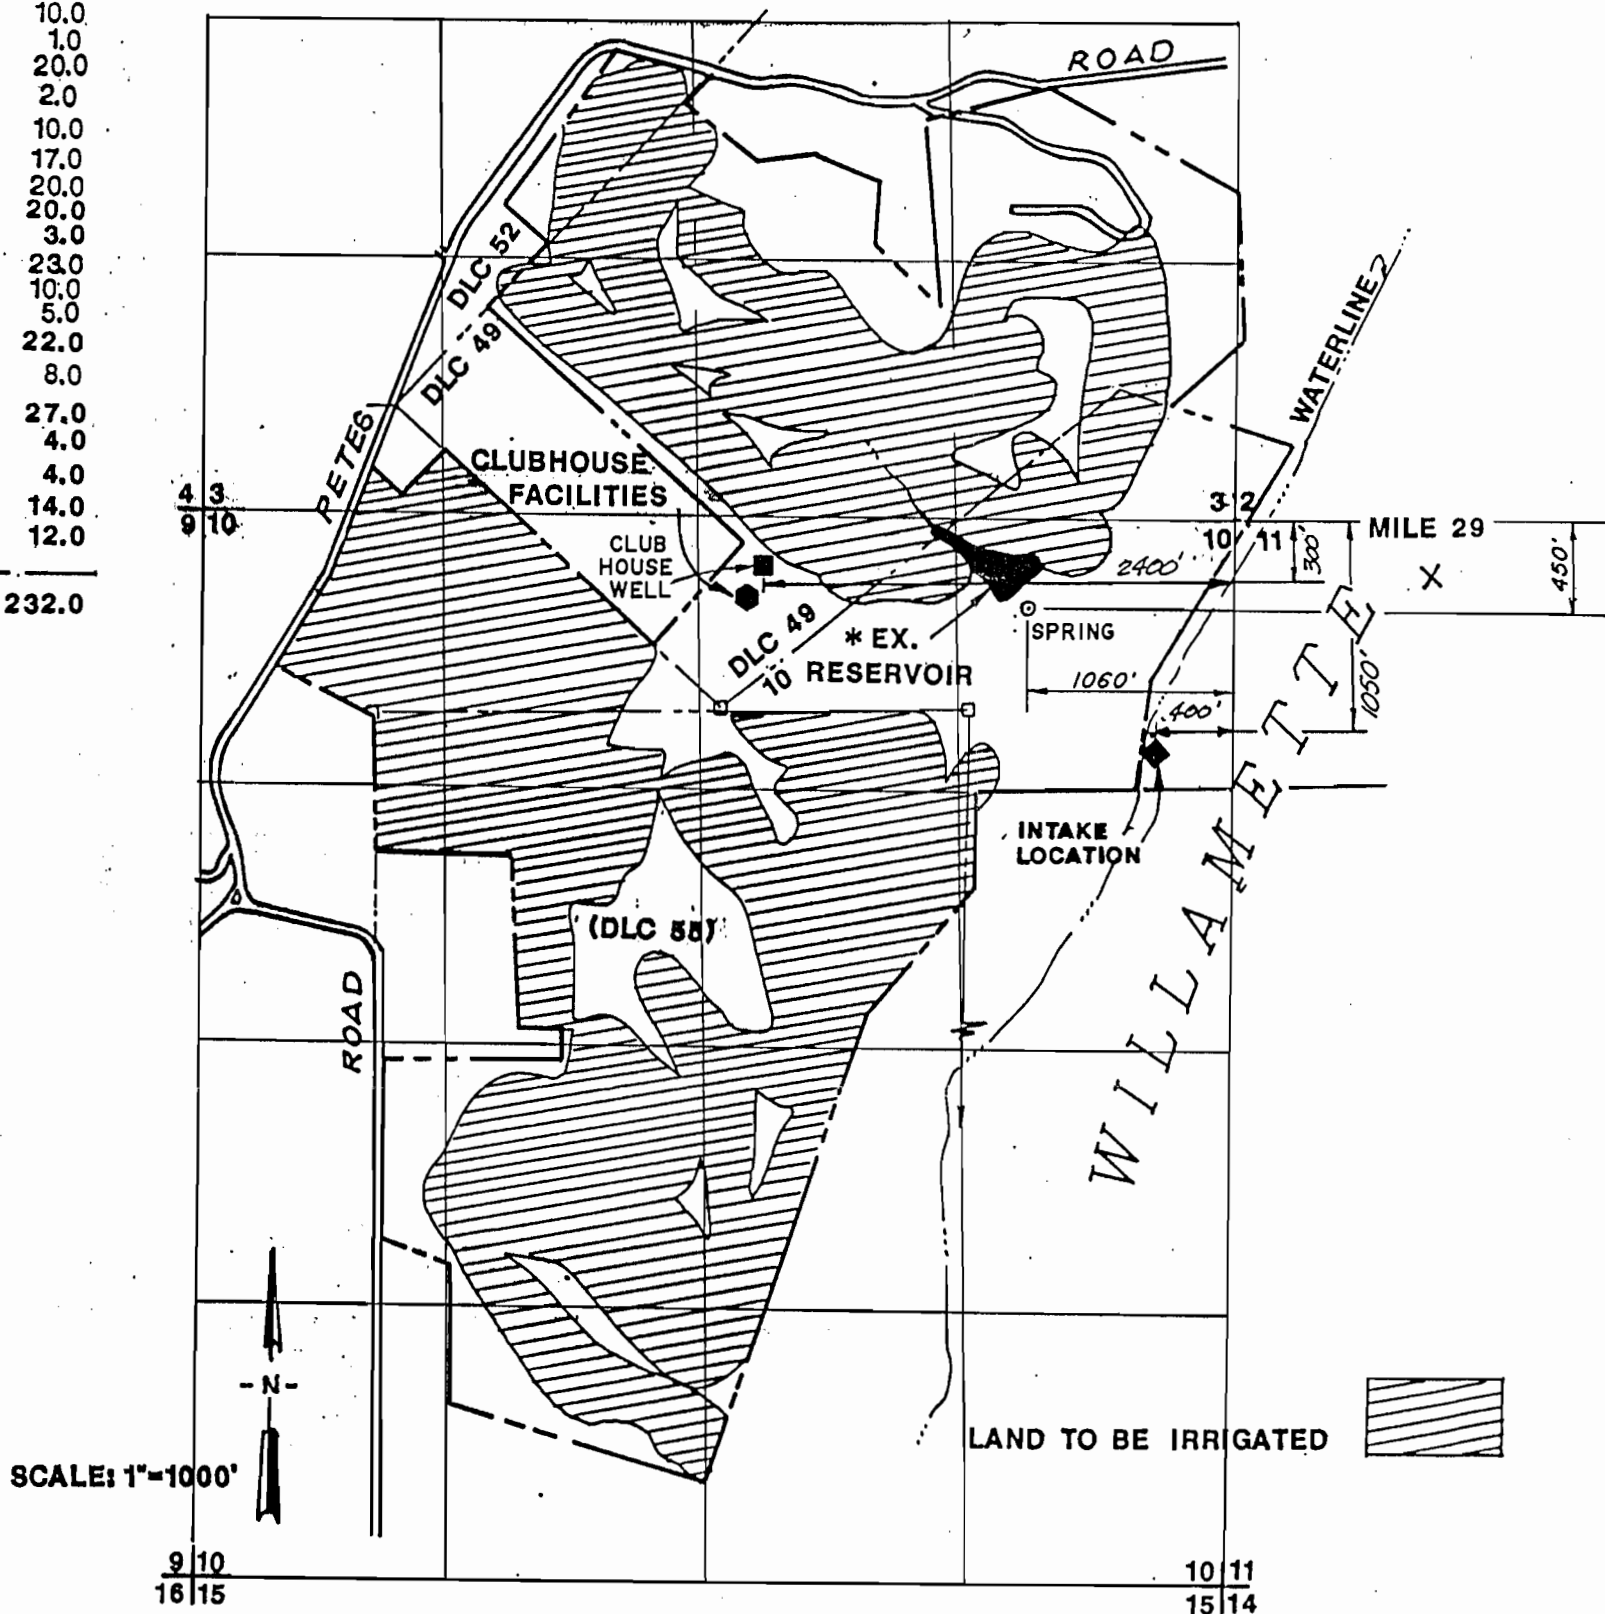

* EXISTING RESERVOIR APPLICATION NUMBERS 47837 AND 49572;
AND PERMIT NUMBER R-5631 AND R-5967

G-12224
G11158

Legal Description

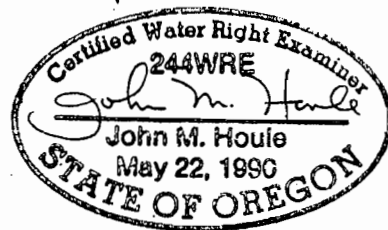

Section 3, Township 3 South, Range 1 East; Tax Lots 600, 700, 703, 800, 900, 990, 1300, 1400 and 1500; Section 10, Township 3 South, Range 1 East; Tax Lots 100, 300, 490, 500, 2000, 2003, 2100, 2102, 2103, 2104, and 2200.

JOHN HOULE CERTIFIED WATER RIGHTS
EXAMINER # 244

otak INC.
Incorporated

17355 S.W. Boones Ferry Rd., Lake Oswego, OR 97035, (503) 635-3618
101 E. 8th Street, Vancouver, WA 98660, (206) 895-0357
25 Central Way, #305, Kirkland, WA 98033, (206) 822-4448

REVISED 11-9-1990
INCLUDE LOCATION
OF SPRING.

RECEIVED

NOV 13 1990

WATER RESOURCES DEPT
SALEM, OREGON