


RECEIVED

T. 8 S. R. 4 W. W. M.

SEP 28 1987

WATER RESOURCES DIV
JANUARY, OREGON

8 9
17 16

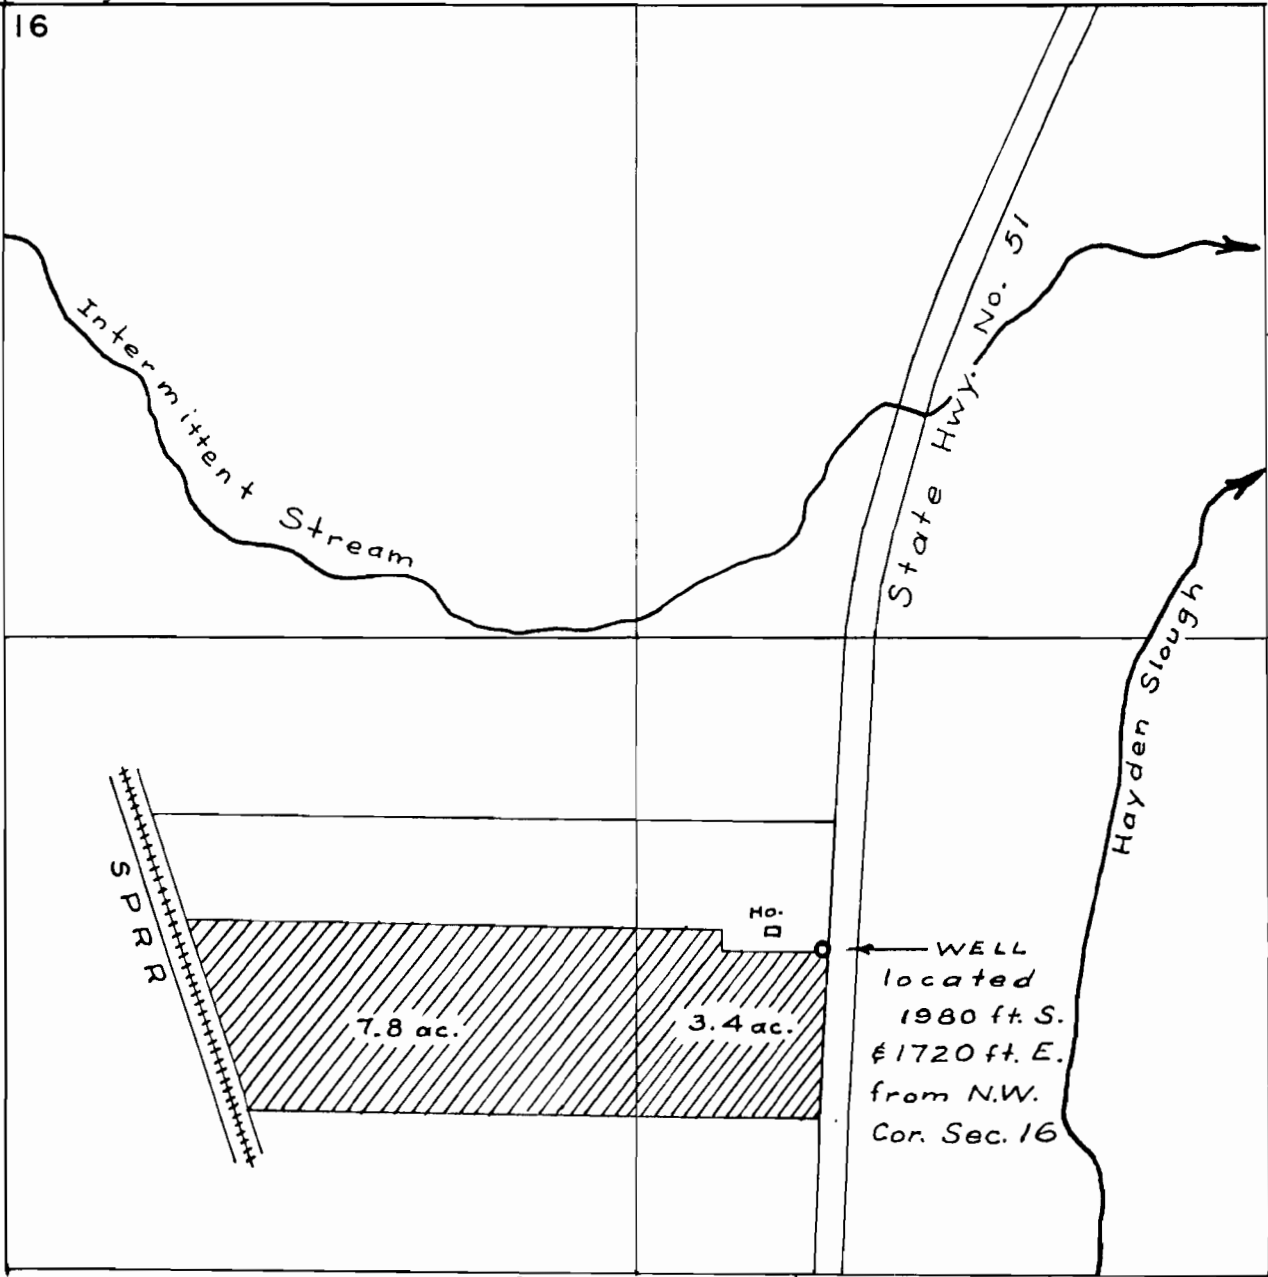

Scale 1" = 400'

FINAL PROOF SURVEY
 APPLIC. G-122 ⁵⁴ PER. G-11161
 IN THE NAME OF
 THOMAS PALACIO

THE PREPARATION OF THIS MAP IS FOR THE
 PURPOSE OF IDENTIFYING THE LOCATION
 OF THE WATER RIGHT ONLY AND HAS NO
 INTENT TO PROVIDE DIMENSIONS OR LOCATION
 OF PROPERTY OWNERSHIP LINES.

