


TAX LOT No. 15-43C-1100


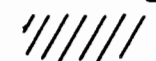

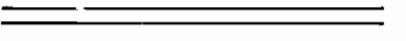
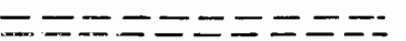
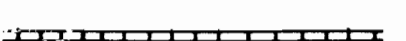



Sec. 32, Twsp. 15 S., R. 43 E., W.M.

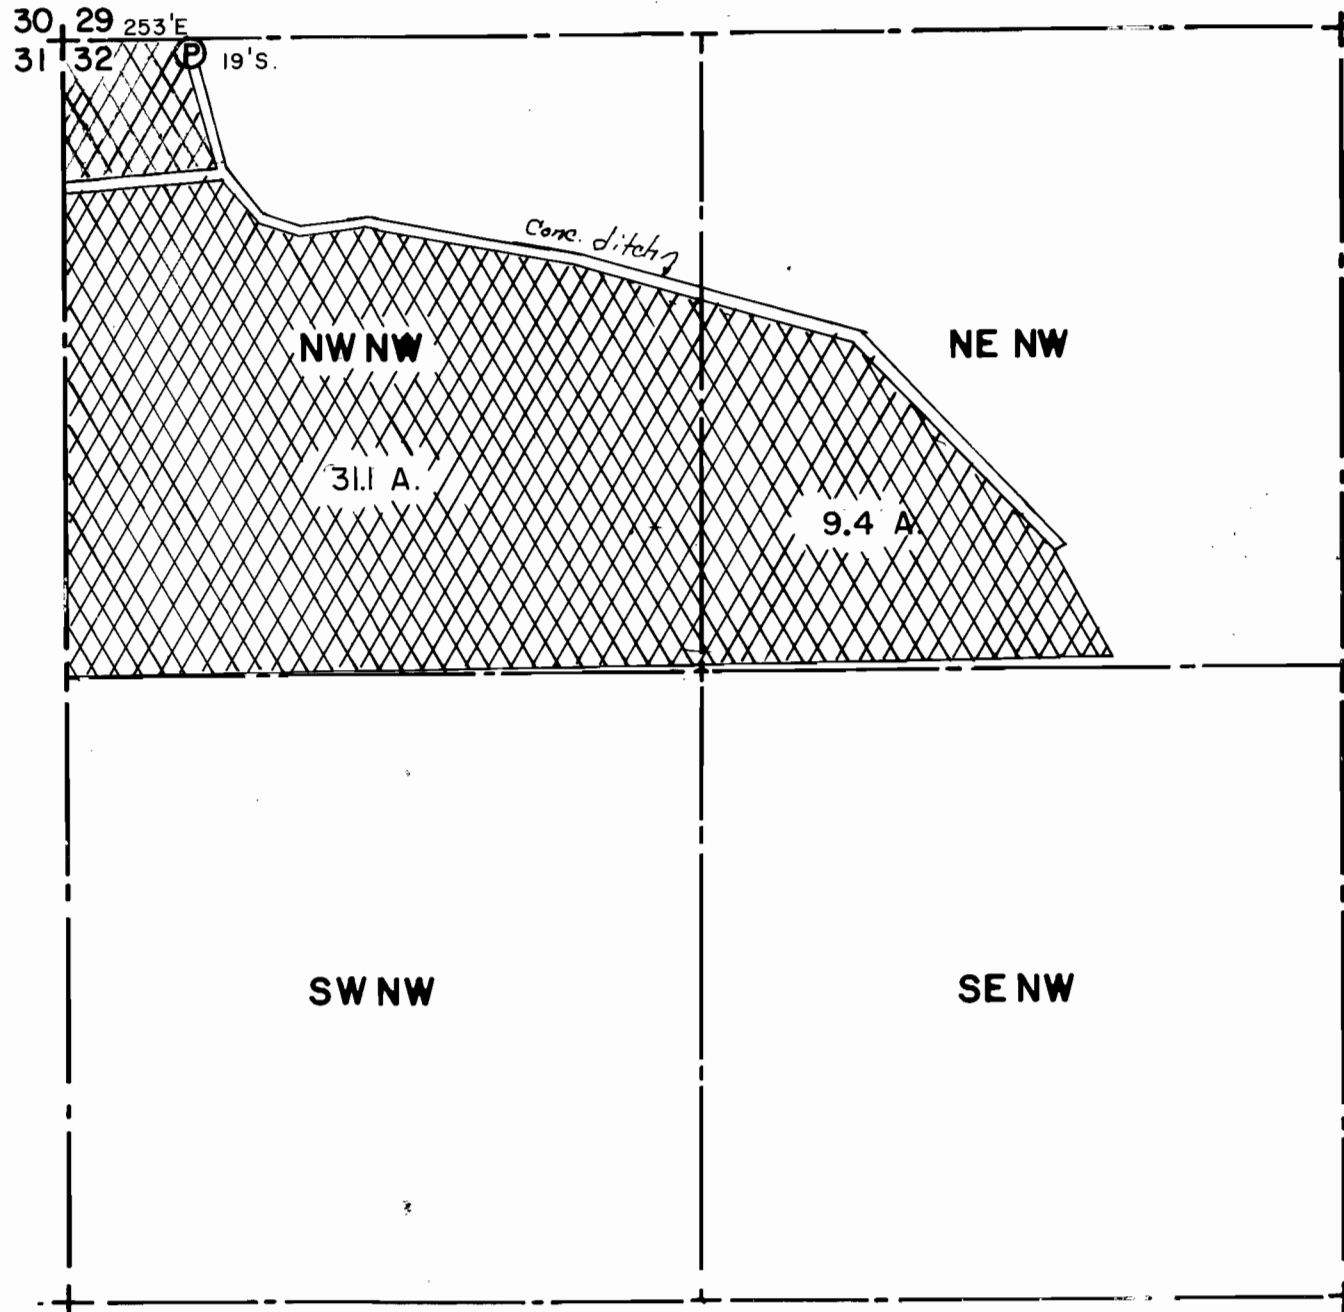

DISCLAIMER

I, ALBERT GASCHLER, HEREBY CERTIFY: THAT THIS MAP WAS MADE TO BE A PART OF THE APPLICATION FOR A FINAL PROOF OF PERMIT No. G-11162. SECTIONAL LINES SHOWN ARE APPROXIMATE AND THIS MAP IS NOT INTENDED FOR ANY OTHER USE AND DOES NOT GUARANTEE LAND OWNERSHIP.

LEGEND


- U.S. GOVERNMENT CORNER 
- EXISTING WATER RIGHT 
- SUPPLEMENTAL WATER RIGHT 
- CONCRETE LINED DITCH 
- EARTH DITCH 
- PIPE LINE 
- SPRINKLER LINE 
- PUMP 
- WEIR BOX 



SCALE: 1" = 400'

Application No. G-11854

Permit No. G-11162

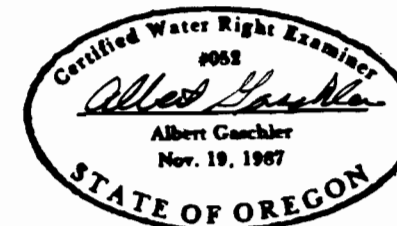

PRIMARY PERMIT No. 21494

FINAL PROOF SURVEY

Rev. 1/4/93 changed
NE NW to 9.4 Ac. Was
9.7 Ac. AG.

WATER RIGHTS EXAMINERS MAP		
FOR: HAMMACK FARMS		
GASCHLER & ASSOCIATES		
ONTARIO, P.O. BOX 412, 889-2101 OREGON		
CHECKED BY: AG	DRAWN BY: AG	APPROVED BY: AG
DATE: 6/92	DRAWING NO. A-517	BKO-2 PG 1
SHEET 3 OF 3	JOB NO. WO-2992	REVISED: 1/4/93