


This drawing is an exhibit for a Final Proof Survey. It is not a Land Survey. Property lines and/or other lines of occupation shown hereon are not represented by the undersigned to meet accuracy standards of Land Surveys.

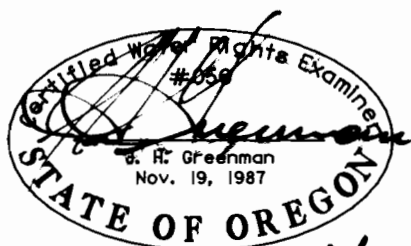

SCALE: 1" = 400'


**SECTION 10, T.2S., R.4E., W.M.
CLACKAMAS COUNTY, OREGON**



94/05/19
Rev 96/04/18

Application No. G-12282

Permit No. G-11167

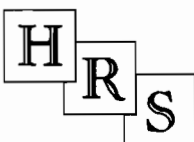

**HANER, ROSS &
SPORSEEN, INC.**

15 S.E. 82ND DRIVE
GLADSTONE, OREGON 97027

PATTERSON NURSERY INC.

FINAL PROOF SURVEY

630CC