



SEC. 19, T.4S, R.1E, W.M.

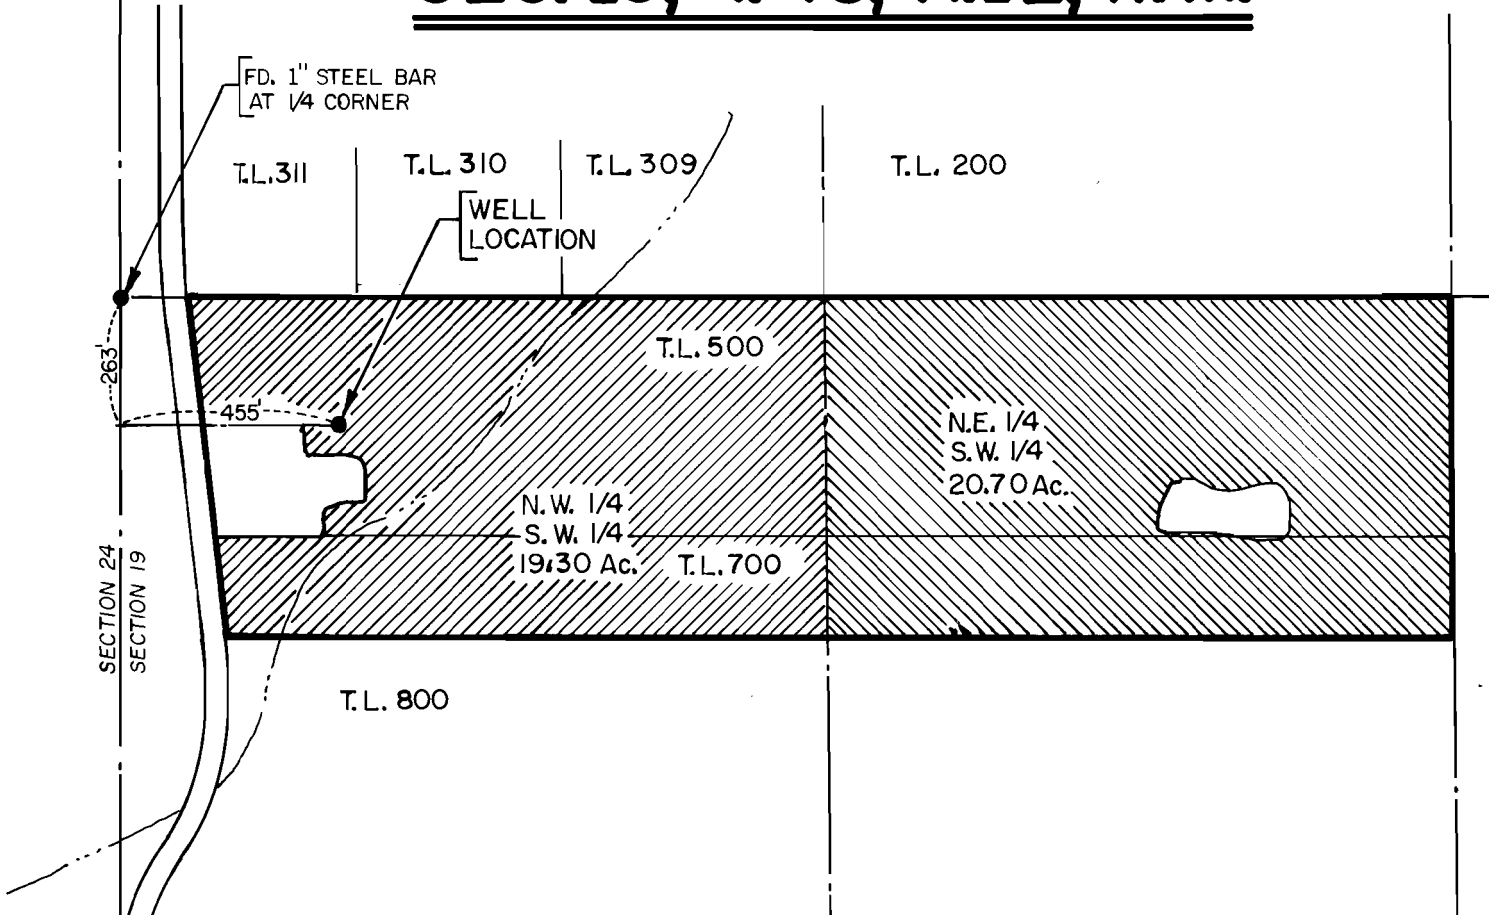

CRUM RD. (CO. RD. NO. 139)

24 19
25 30

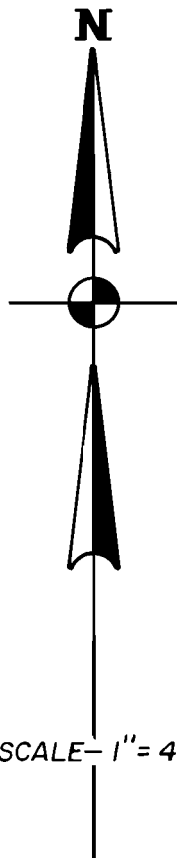



SCALE— 1" = 400'

FILE NO. G-12302
PERMIT NO. 11178

FINAL PROOF SURVEY FOR HOWARD CALCAGNO

NOTE:

THIS MAP IS FOR THE PURPOSE OF IDENTIFYING THE LOCATIONS OF THE WATER RIGHT ONLY AND HAS NO INTENT TO PROVIDE DIMENSIONS OR LOCATION OF PROPERTY OWNERSHIP LINES.

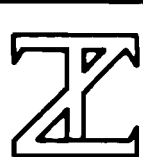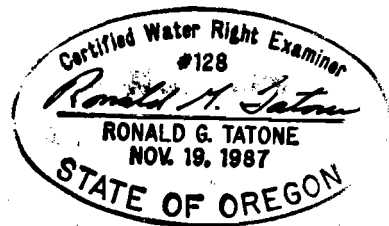

**ZAROSINSKI - TATONE
ENGINEERS, INC.**

3737 S. E. 6TH AVENUE, PORTLAND, OREGON 97202

PHONE: (503) 235-8798