
Township 5 & 6 South, Range I East, W.M.

Portions of Sections 32 & 33 in Township 5 South and Sections 4 & 5 in Township 6 South

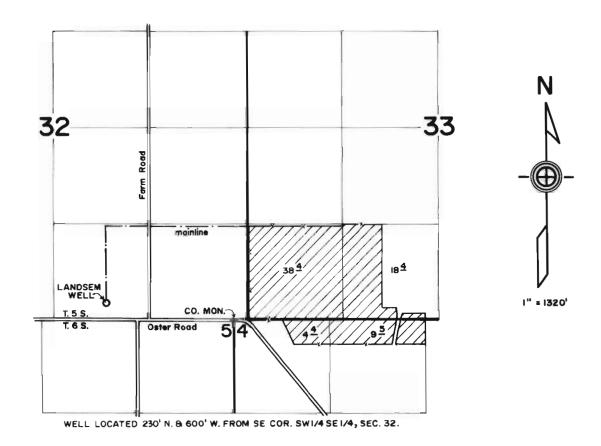

FINAL PROOF SURVEY under

Appl. No. G-12192, Per. No. G-11183 in name of

KRAEMER FARMS

September 21, 1993





THIS MAP WAS PREPARED FOR THE PURPOSE OF IDENTIFYING THE LOCATION OF A WATER RIGHT ONLY AND IS NOT INTENDED TO PROVIDE LEGAL DIMENSIONS OR LOCATION OF PROPERTY OWNERSHIP LINES.