


Township 6 South, Range 3 West, W.M.

A Portion of Section 29

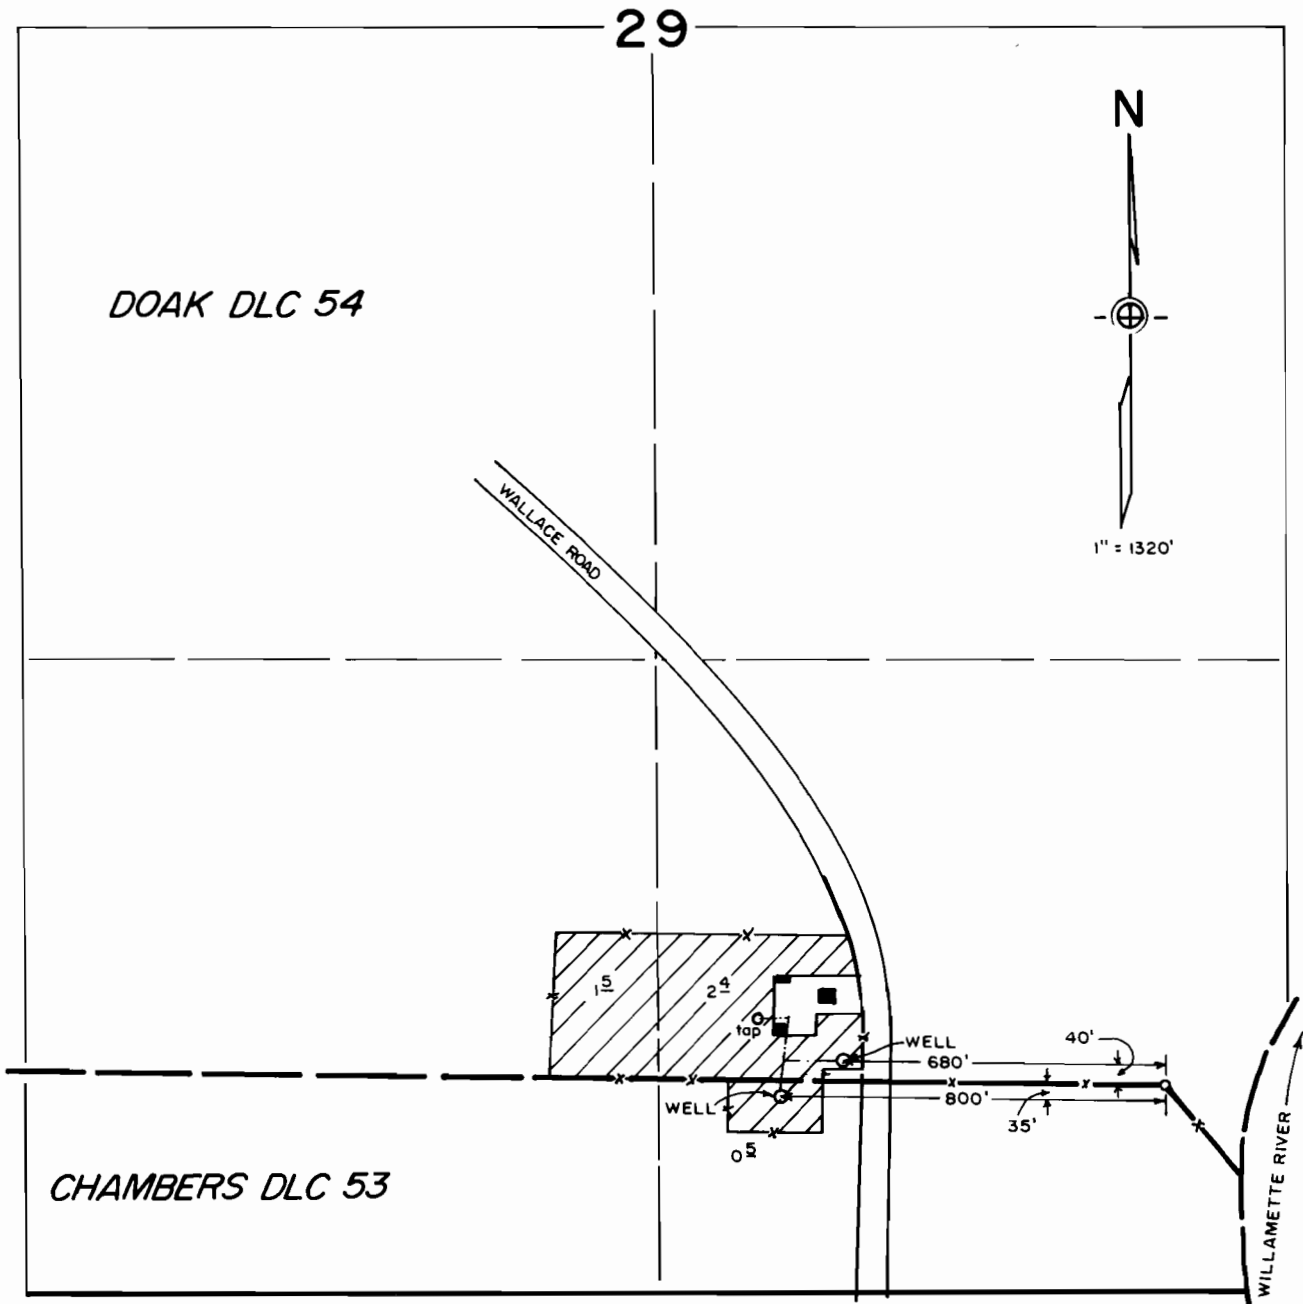

FINAL PROOF SURVEY


under

Appl. No. G-12197, Per. No. G-11190

in name of

LLOYD AND MARJO NELSON

October 28, 1993

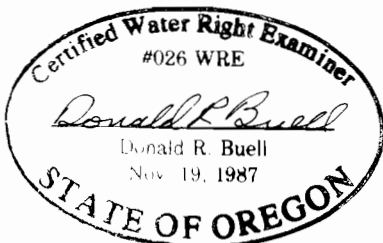

THIS MAP WAS PREPARED FOR THE PURPOSE OF IDENTIFYING THE LOCATION OF A WATER RIGHT ONLY AND IS NOT INTENDED TO PROVIDE LEGAL DIMENSIONS OR LOCATION OF PROPERTY OWNERSHIP LINES.