



T.5 S. R.2 E., W. M.

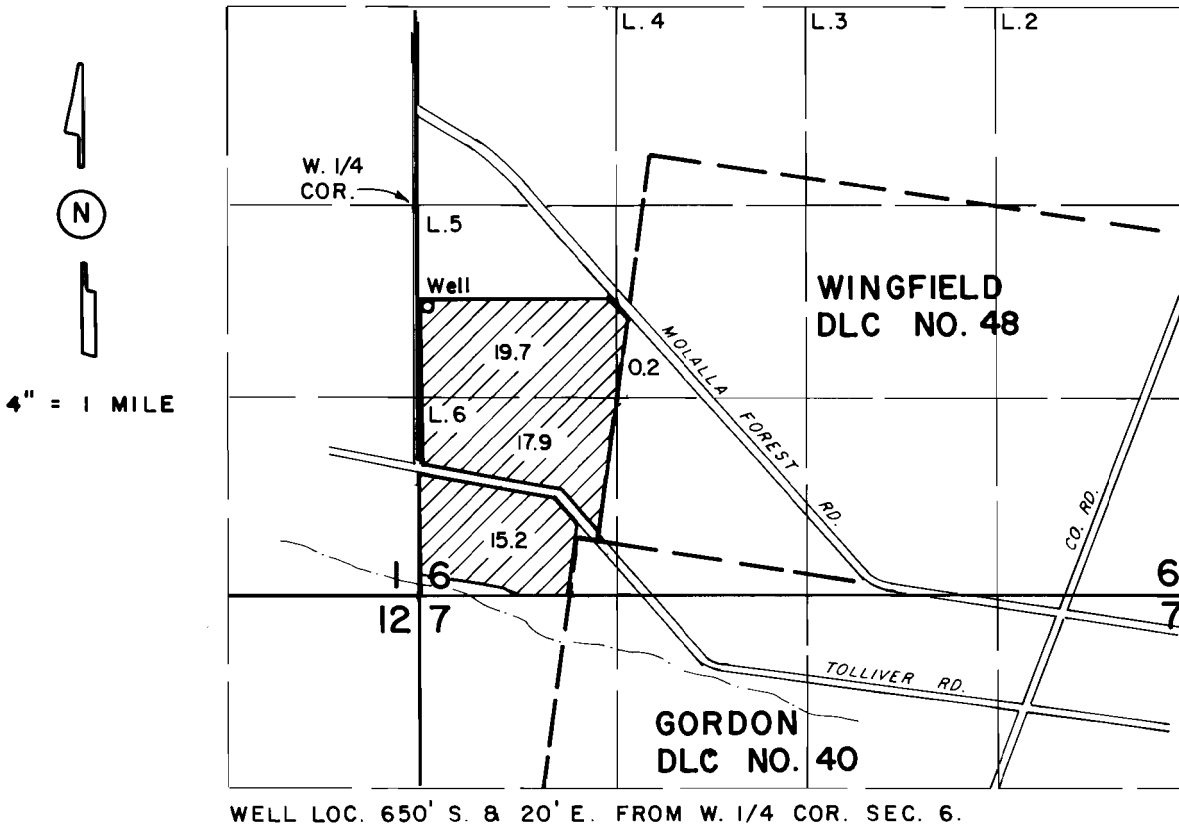

WATER RIGHT MAP FOR

DENNIS K. & DOUGLAS L. HOPPER

SURVEYED ON AUGUST 11, 1994

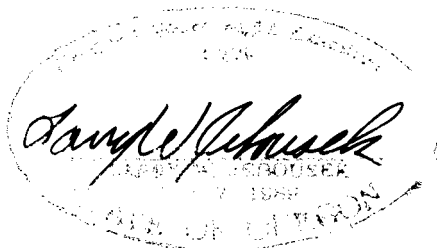

THIS MAP WAS PREPARED FOR THE PURPOSE OF IDENTIFYING THE LOCATION OF A WATER RIGHT ONLY AND IS NOT INTENDED TO PROVIDE LEGAL DIMENSIONS OR LOCATION OF PROPERTY OWNERSHIP LINES.