
RECEIVED

JUN 1 9 1989

T6S., R.2 & 3W., W.M.

RECEIVED

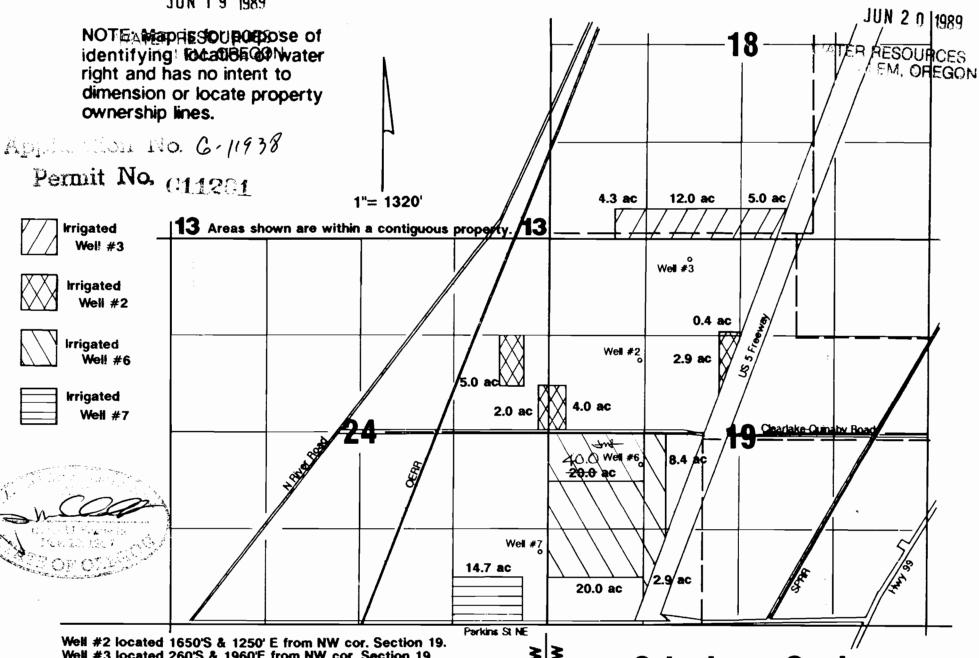

Well #2 located 1650'S & 1250' E from NW cor. Section 19 Well #3 located 260'S & 1960'E from NW cor. Section 19. Well #6 located 2200'N & 1300'E from SW cor. Section 19. Well #7 located 1002'N & 95'W from SE cor. Section 24.

RZW

Schreiners Gardens Application Map