


T1N., R2W., W.M.

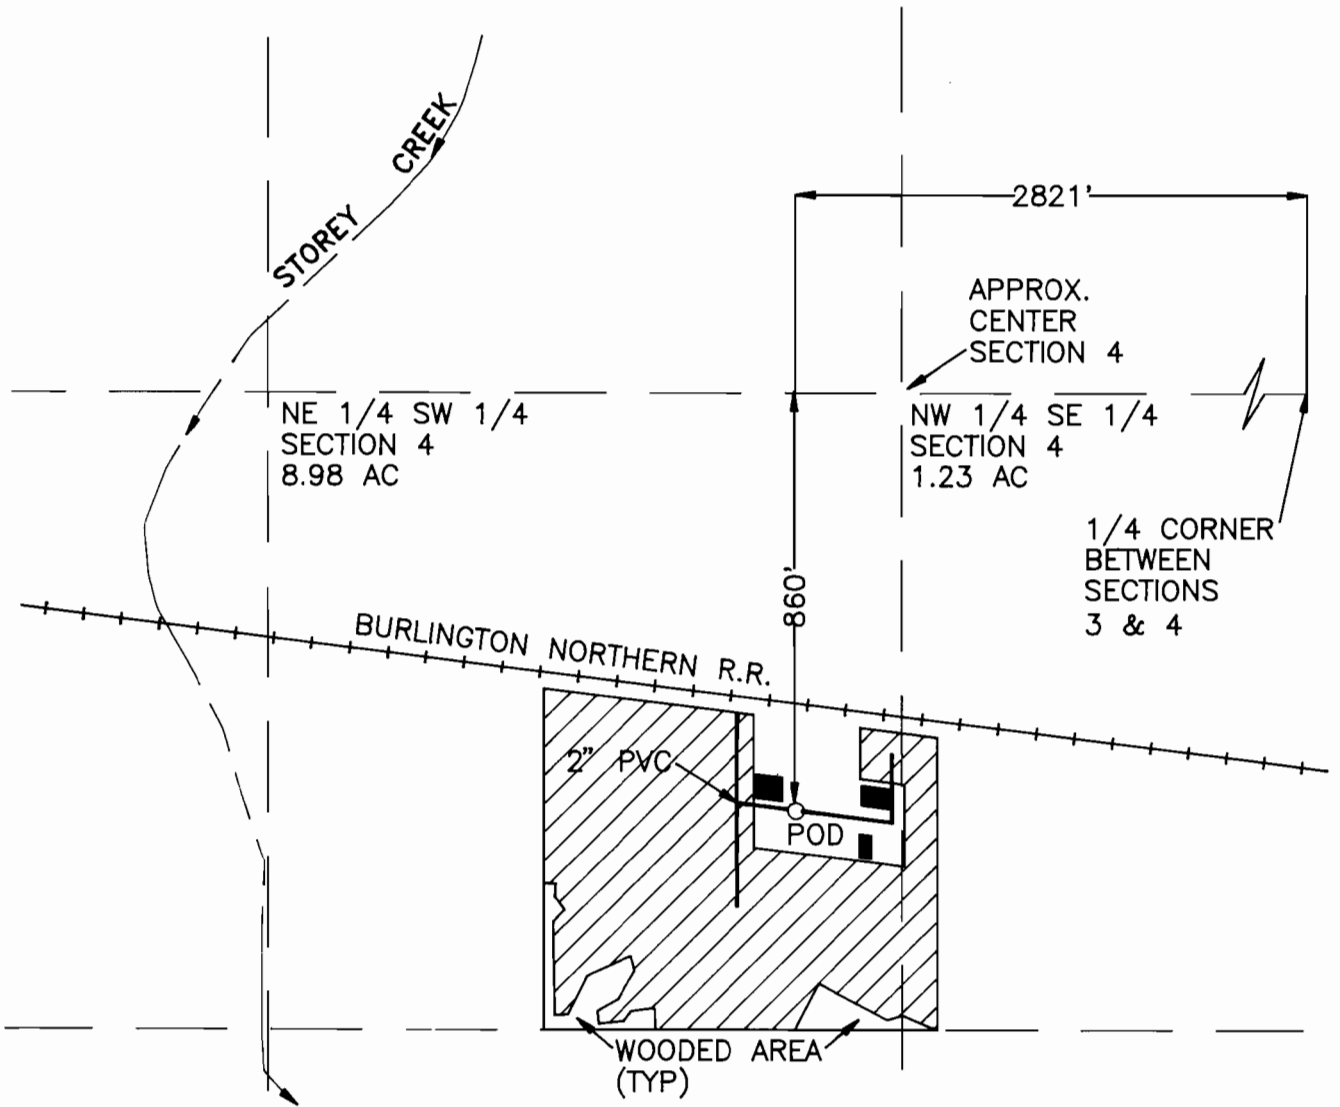

FINAL PROOF SURVEY

UNDER

Application No. G-12201 Permit No. G-11213

IN NAME OF

FRANK & KAREN REIMERS

Surveyed SEPTEMBER 13, 1993, by DAN KEPPEM



SCALE: 1" = 400'



THIS MAP IS FOR THE PURPOSE OF IDENTIFYING THE LOCATION OF THE WATER RIGHT ONLY AND IS NOT INTENDED TO PROVIDE LEGAL DIMENSIONS OR THE LOCATION OF PROPERTY OWNERSHIP LINES.