


# T. 7 S. R. 39 E., W.M.

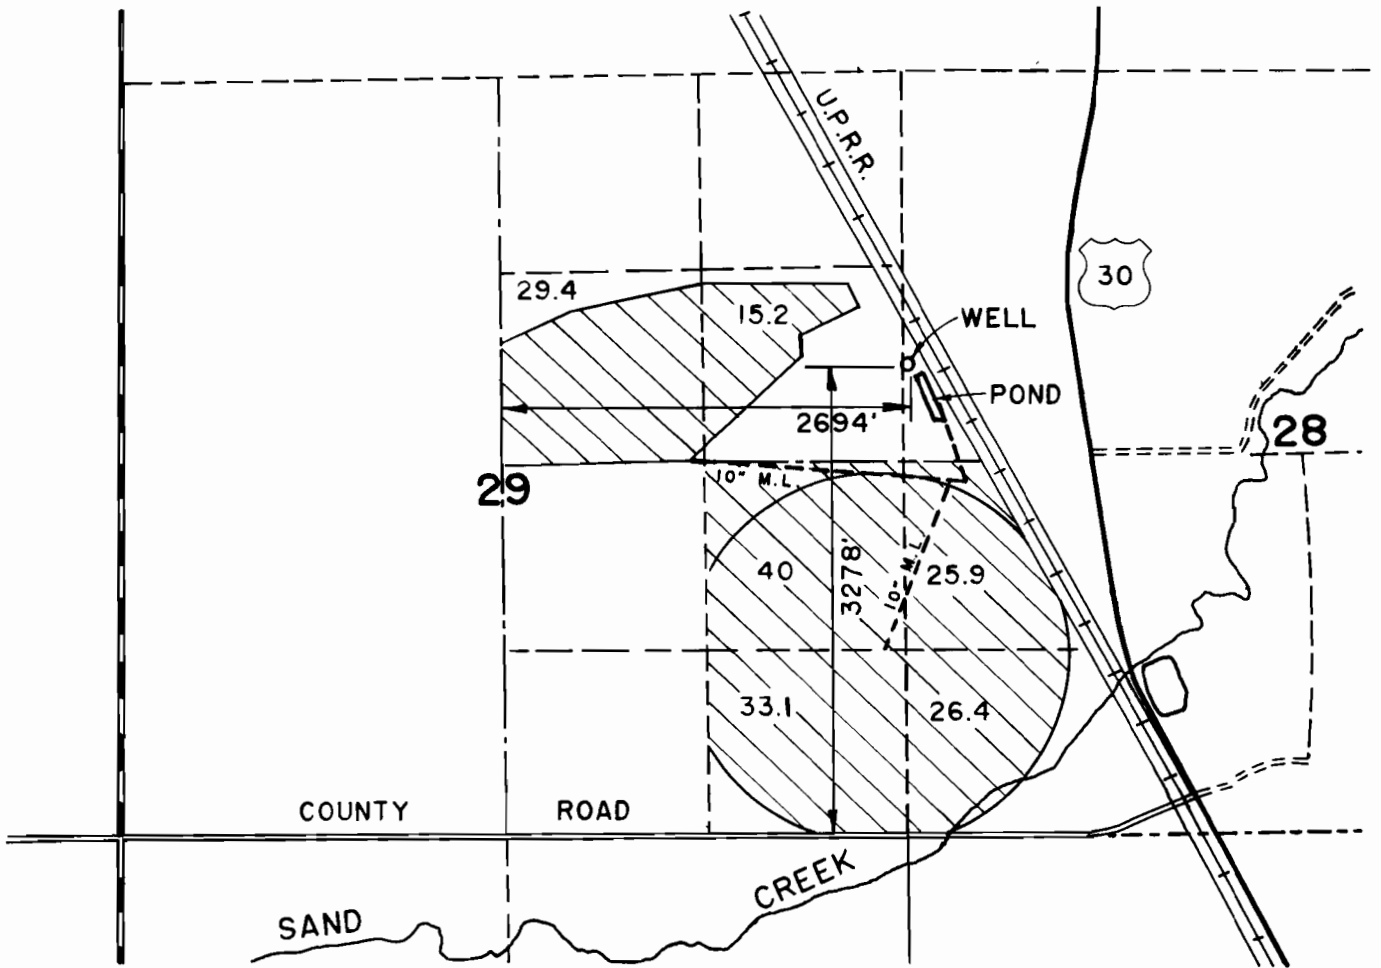

SCALE 1" = 1320'

The purpose of this map is for identifying the location of the water right only and is not intended to provide legal dimensions of property ownership lines.

## FINAL PROOF SURVEY

UNDER

Application No. G-12266 Permit No. G-11219

IN NAME OF

L.M. and M.S. Ingram Trust

Surveyed September 20, 1995

