
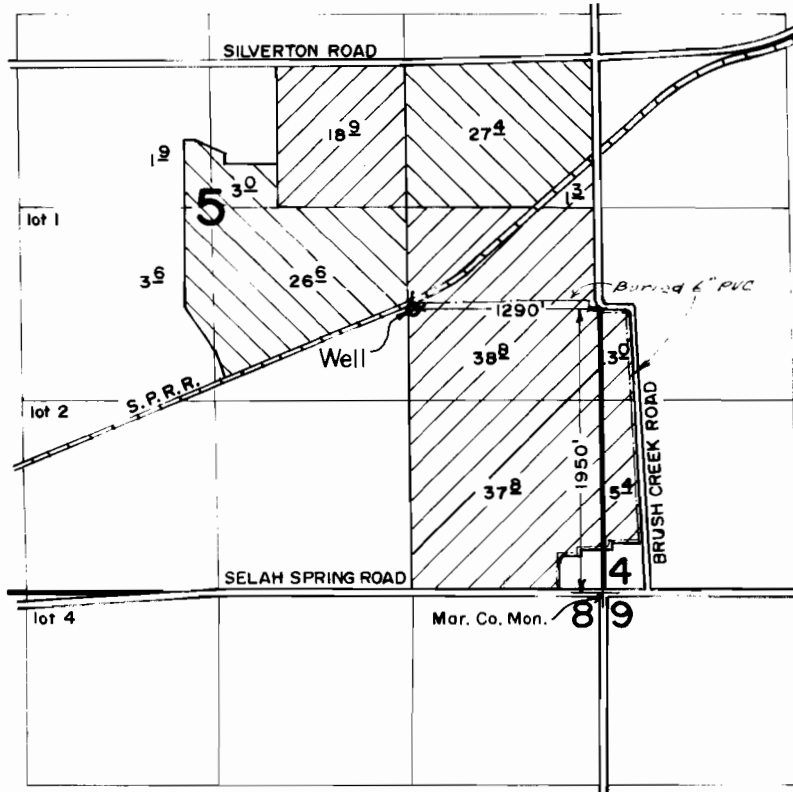



# Township 7 South, Range 1 West, W.M.

Portions of Sections 4, 5, 8 & 9

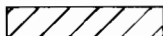

-  Primary
-  Supplemental

## FINAL PROOF SURVEY


under

Appl. No. G-12364, Per. No. G-11258

in name of

BLUE LINE FARMS, INC.

August 14, 1995

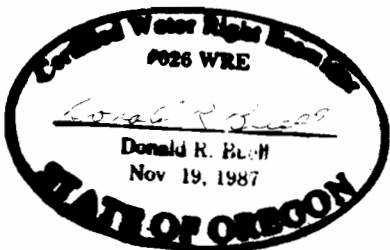

THIS MAP WAS PREPARED FOR THE PURPOSE OF IDENTIFYING THE LOCATION OF A WATER RIGHT ONLY AND IS NOT INTENDED TO PROVIDE LEGAL DIMENSIONS OR LOCATION OF PROPERTY OWNERSHIP LINES.