


Township 7 South, Ranges 1 West & 2 West, W.M.


A Portion of Section 7 in Range 1 West
& Section 12 in Range 2 West

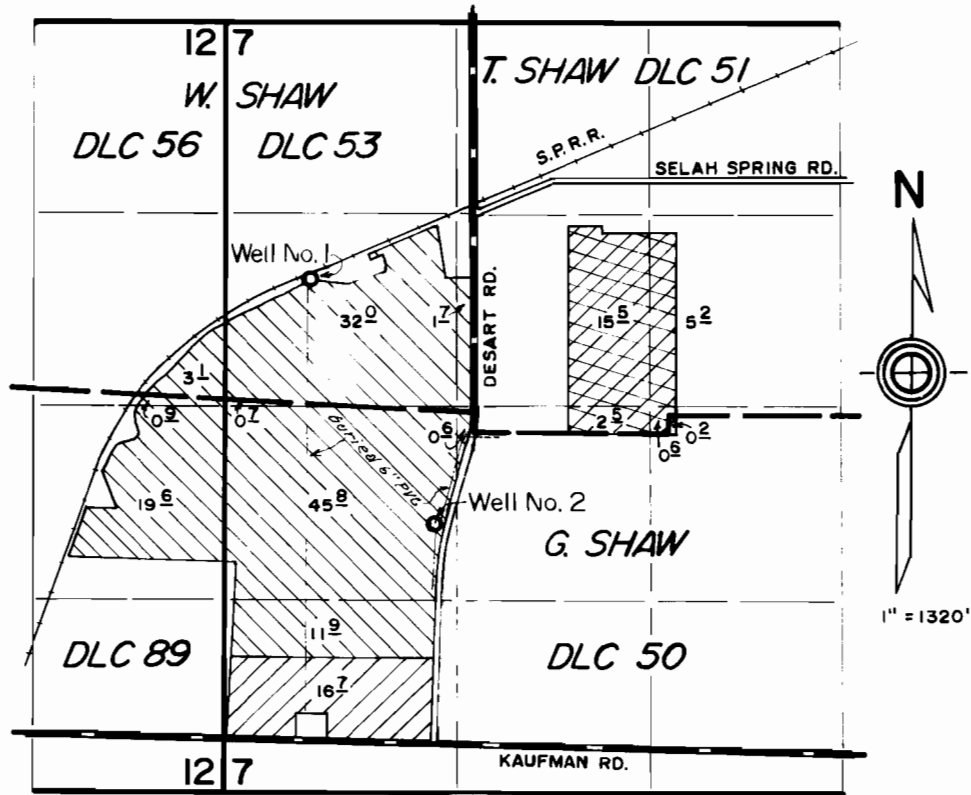

WELLS LOCATED: No. 1 - 1070' N. and 1120' W., No. 2 - 610' S. and 270' W.
BOTH FROM SW COR. DLC 51.

 PRIMARY BOTH WELLS
  PRIMARY WELL No. 2
  SUPPLEMENTAL WELL No. 2

FINAL PROOF SURVEY
under
Appl. No. G-12365, Per. No. G-11259
in name of
BLUE LINE FARMS, INC.
August 14, 1995

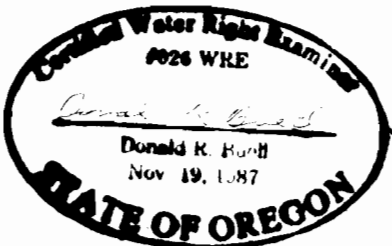

THIS MAP WAS PREPARED FOR THE PURPOSE OF IDENTIFYING THE LOCATION OF A WATER RIGHT ONLY AND IS NOT INTENDED TO PROVIDE LEGAL DIMENSIONS OR LOCATION OF PROPERTY OWNERSHIP LINES.