

Application No. *G-12264*
Permit No. *G11262*
T. 4S. R. 2W., W.M.


RECEIVED

OCT 17 1990

WATER RESOURCES DE
SALEM, OREGON



4" = 1 MI.

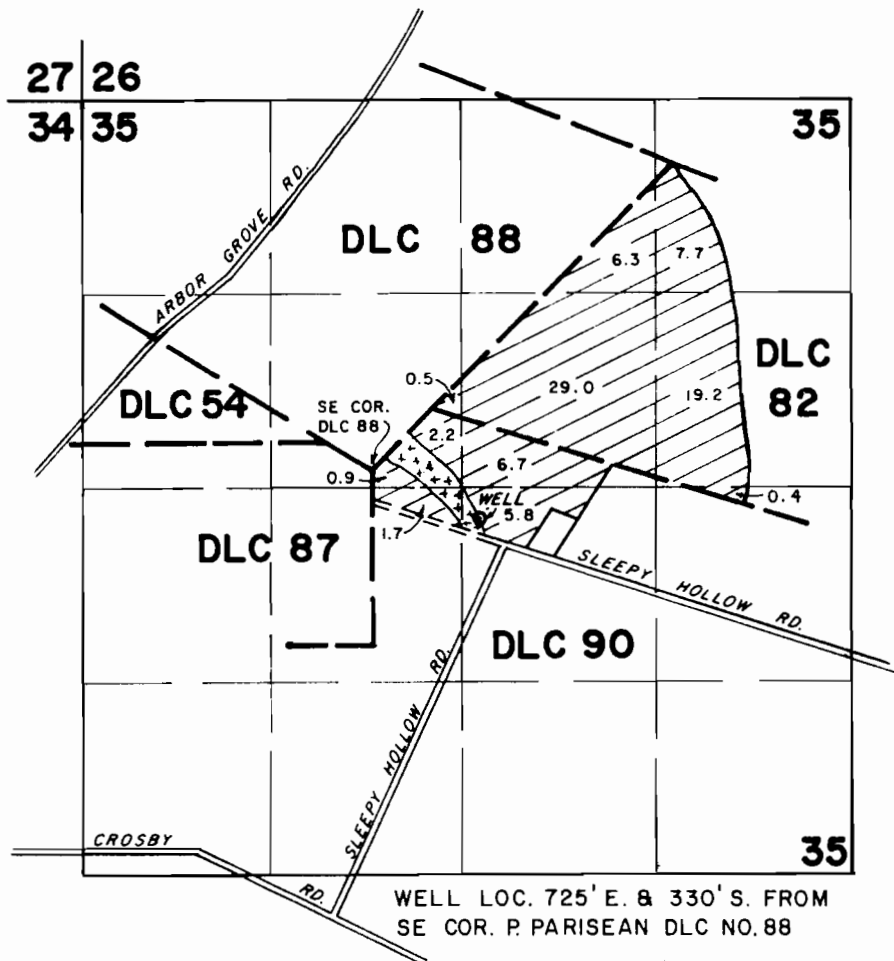

WATER RIGHT MAP FOR

STAN DANSKEY

SURVEYED ON SEPT. 7, 1990

BY: *Nancy W. Johnson*
Nancy W. Johnson
Central Water Right Examiners
STATE OF OREGON