


Township 6 South, Range 1 West, W.M.

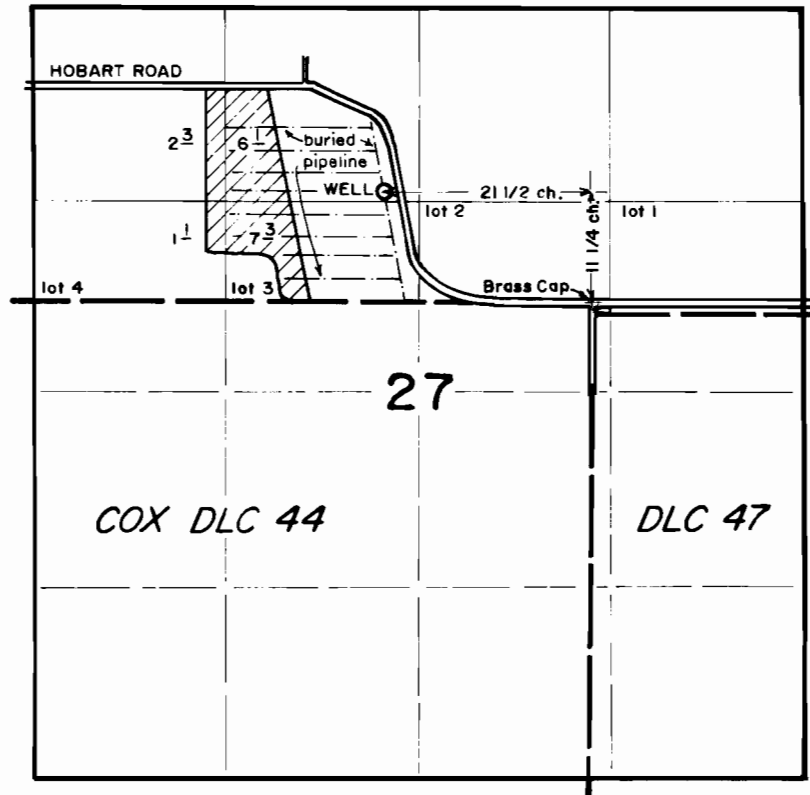


Appl. No. G-12297

Per. No. G-11264

FINAL PROOF SURVEY  
in name of

GOSCHIE FARMS, INC.

September 10, 1991

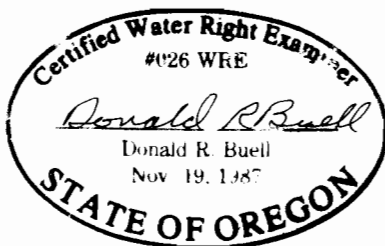

THIS MAP WAS PREPARED FOR THE PURPOSE OF IDENTIFYING THE LOCATION OF A WATER RIGHT ONLY AND IS NOT INTENDED TO PROVIDE LEGAL DIMENSIONS OR LOCATION OF PROPERTY OWNERSHIP LINES.