


# T. 8 S. R. 39 E. W.M.

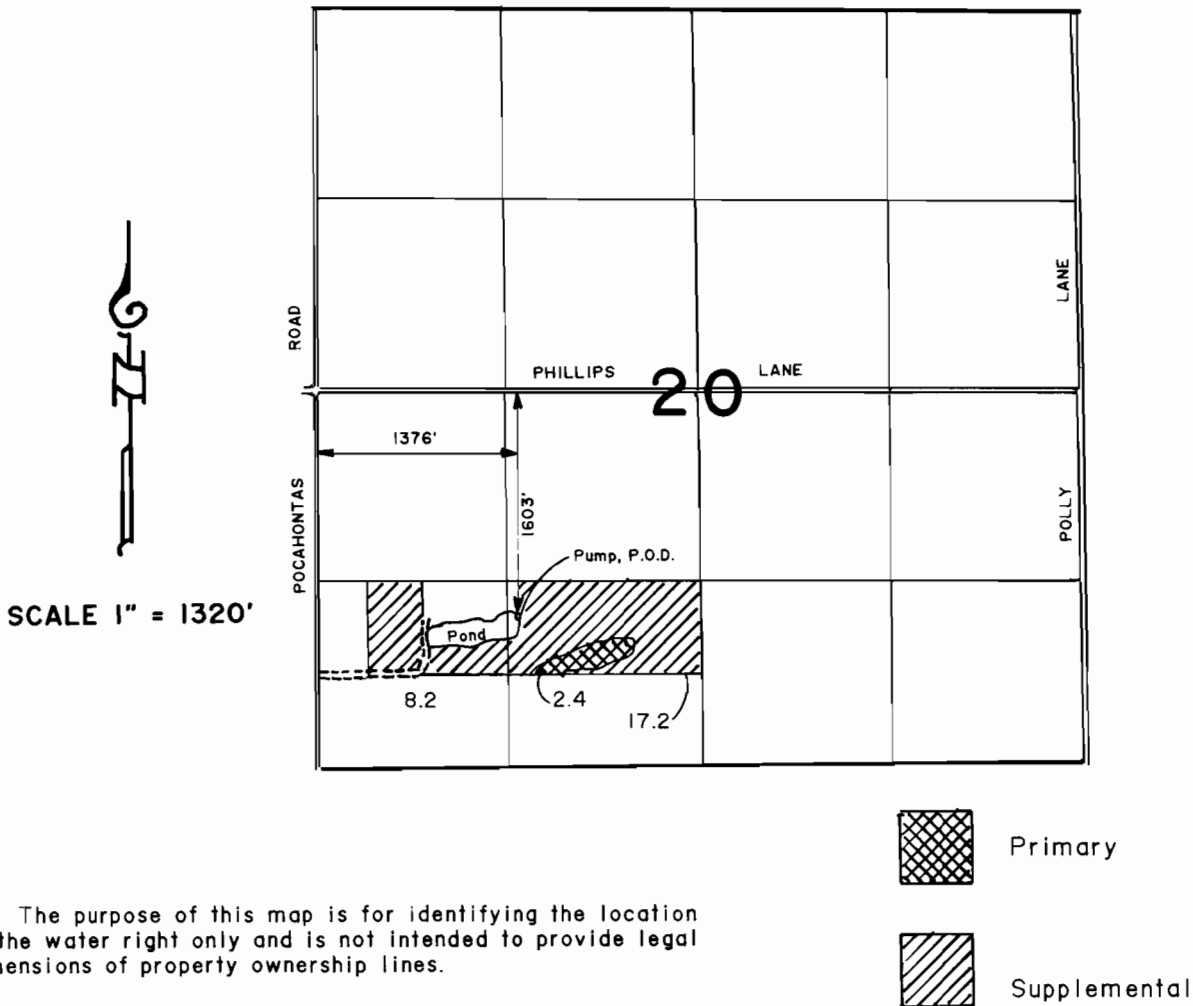

The purpose of this map is for identifying the location of the water right only and is not intended to provide legal dimensions of property ownership lines.

## FINAL PROOF SURVEY UNDER

Application No. G-12360 Permit No. G-11267

IN NAME OF

FRANK L. and ODETTA MILLER

Surveyed September 22, 1994

