


# T.7S. R.2W., W.M.

WATER RESOURCES  
DIVISION

N  
4" = 1 MILE

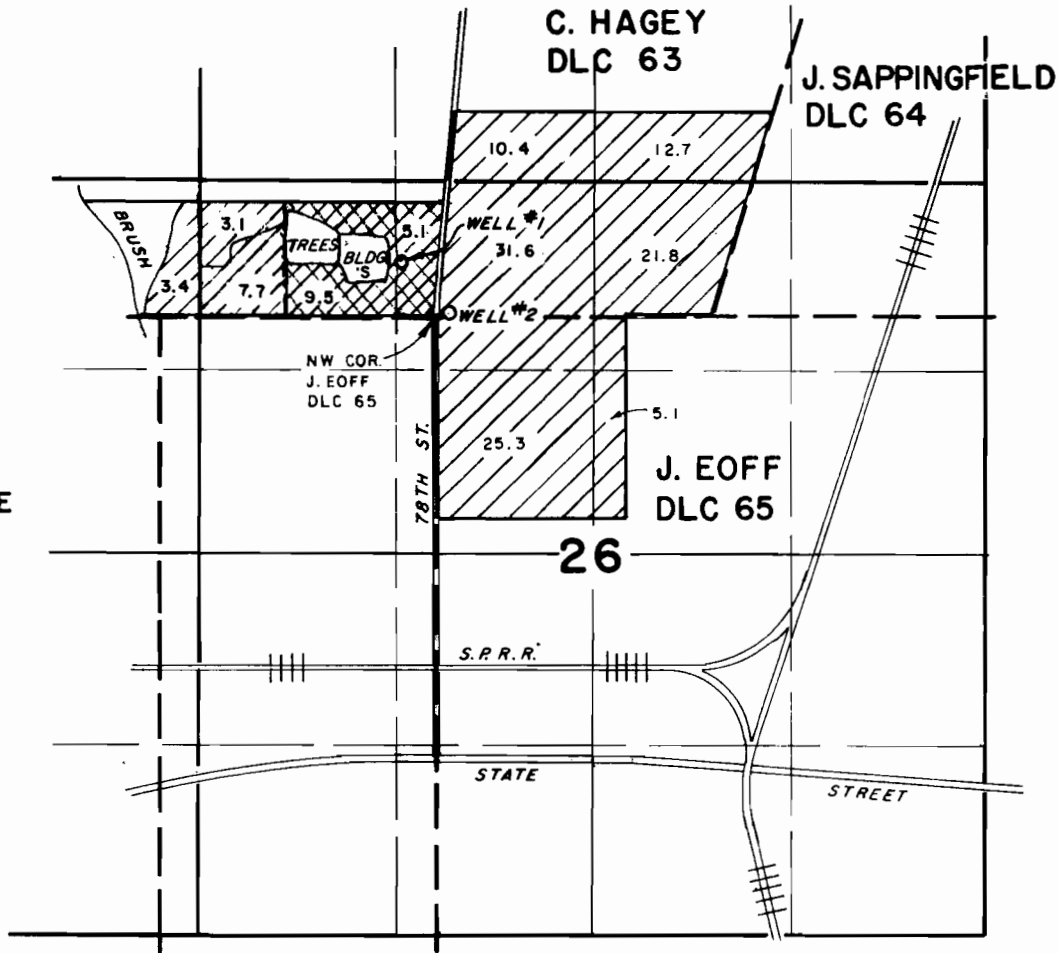

WELL NO. 1 (GR-3043) LOC. 336' N. & 200' W. OF NW COR. J. EOFF DLC 65  
WELL NO. 2 LOC. 58' E. OF NW COR. J. EOFF DLC 65

WELL 2

WELL 1

## FINAL PROOF SURVEY FOR DAN SANDAU

SURVEYED ON JULY 11, 1994

THIS MAP WAS PREPARED FOR THE PURPOSE OF IDENTIFYING THE LOCATION OF A WATER RIGHT ONLY AND IS NOT INTENDED TO PROVIDE LEGAL DIMENSIONS OR LOCATION OF PROPERTY OWNERSHIP LINES.

