


T.8 S. R. 39 E., W.M.

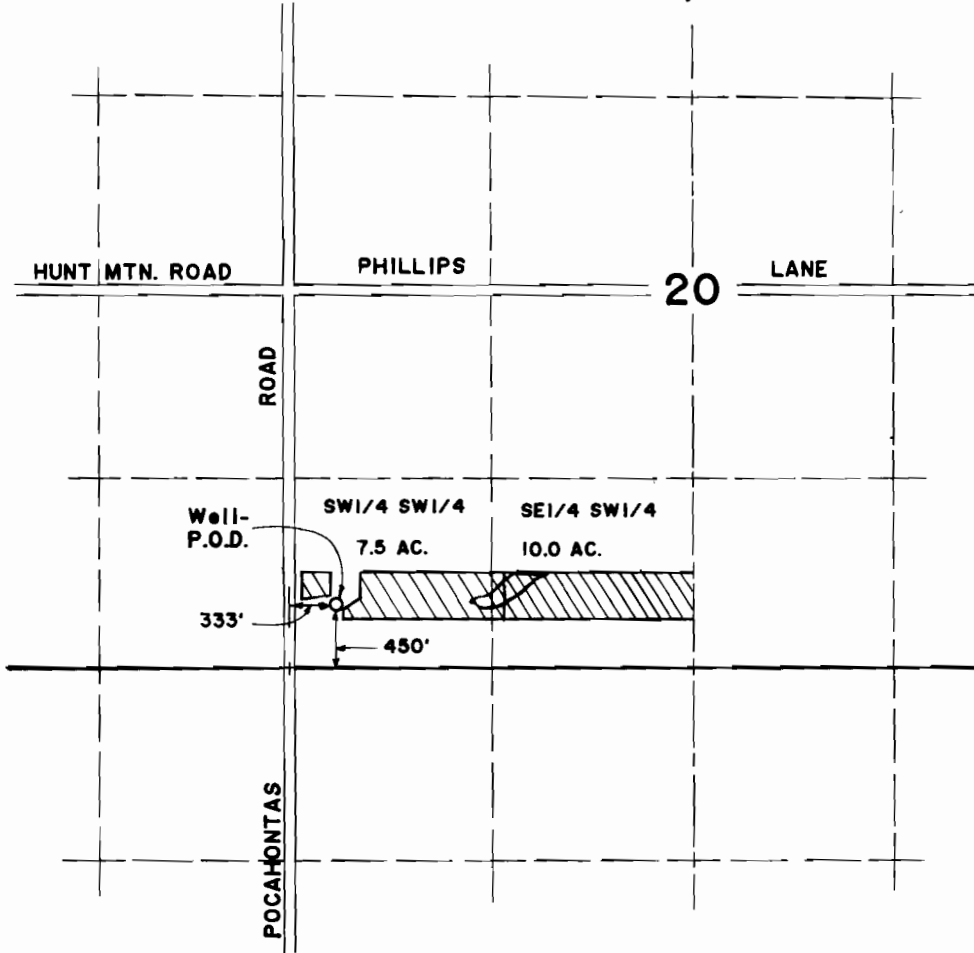

SCALE 1" = 1320'

The purpose of this map is for identifying the location of the water right only and is not intended to provide legal dimensions of property ownership lines.

FINAL PROOF SURVEY

UNDER

Application No. G-12159 Permit No. G-11290

IN NAME OF

Walter W. and Cathryn J. Zimmerman

Surveyed September 21, 1995

