


THIS MAP WAS PREPARED FOR THE PURPOSE OF  
 SHOWING THE LOCATION OF A WATER RIGHT  
 ONLY AND IS NOT INTENDED TO PROVIDE LEGAL  
 OPINION ON LOCATION OF PROPERTY  
 LINES.

**RECEIVED**




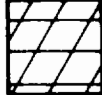
JUN 4 1993

WATER RESOURCES DEPT  
 SALEM, OREGON

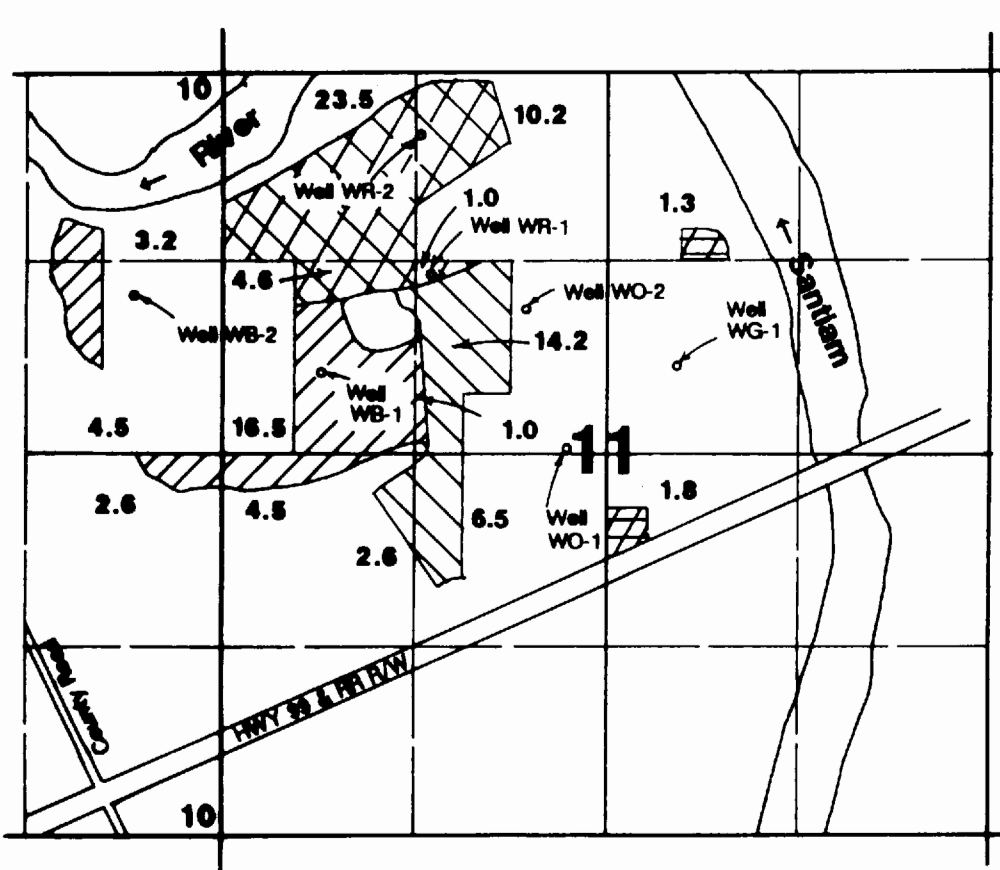
**T.10S., R.3W., W.M.**



1" = 1320'

-  Well WB-1 & WB-2
-  Well WR-1 & WR-2
-  Well WO-1 & WO-2
-  Well WG-1

- Well WB-1 located 550N & 890E from W 1/4 corner Section 11.
- Well WB-2 located 1070N & 600W from W 1/4 corner Section 11.
- Well WR-1 located 1225N & 1190W from center Section 11.
- Well WR-2 located 430S & 1350E from NW corner Section 11.
- Well WO-1 located 36N & 270W from center Section 11.
- Well WO-2 located 960N & 540W from center Section 11.
- Well WG-1 located 560N & 485E from center Section 11.

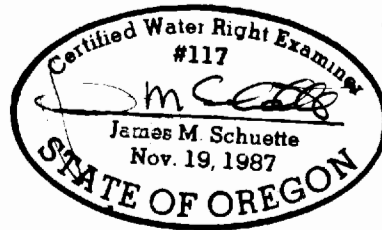

**Final Proof Survey**

**Application # G-12314      Permit #G-11299**

In Name Of

**Weddle Farms**

**Surveyed April 19, 1993 by JM Schuette**