



T.7S. R.2W. Sec. 7 and 18


DLC 48

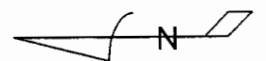

EXPIRATION DATE: 6/30/03

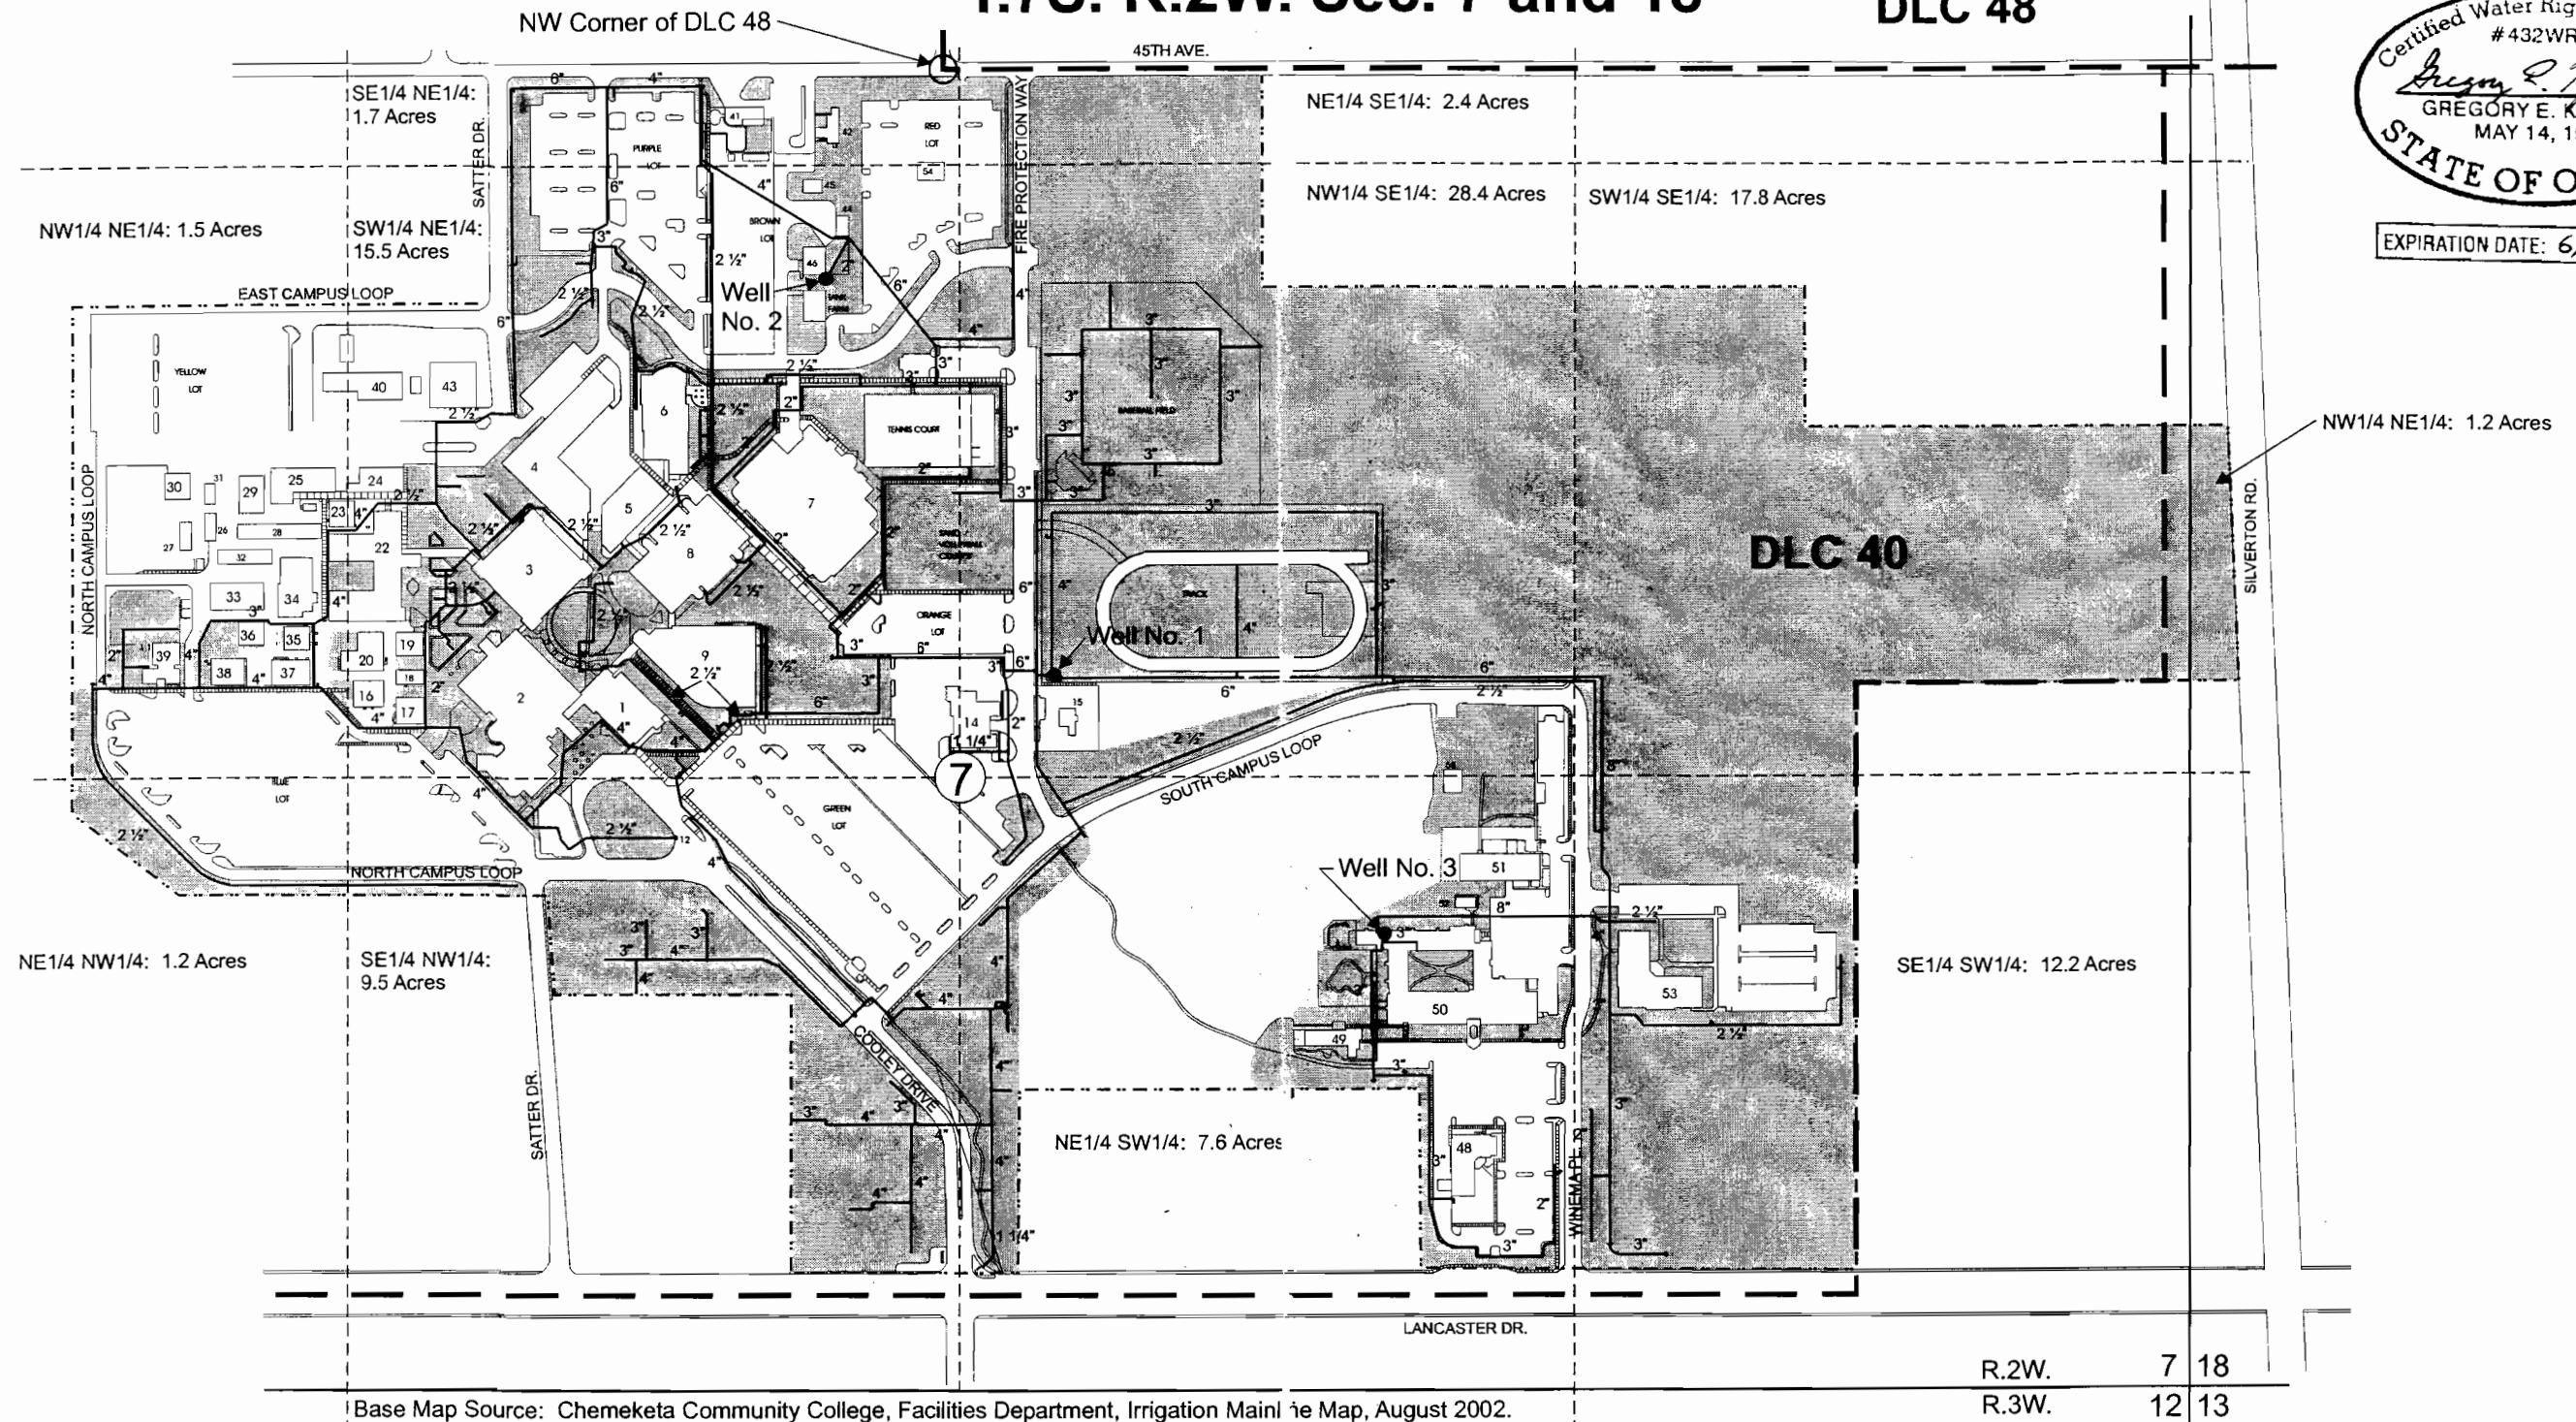

Scale: 1" = 400'

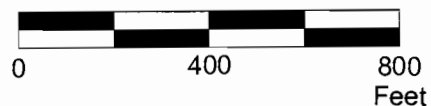

Well Locations From Northwest Corner of DLC 48:
 Well No. 1 - 240 feet south and 1,310 feet west
 Well No. 2 - 260 feet north and 450 feet west
 Well No. 3 - 955 feet south and 1,870 feet west

Area (99.0 Acres) irrigated under Application G-12324, Permit G-11304.

This map was prepared for the purpose of identifying the location of a water right only and is not intended to provide legal dimensions or location of property ownership lines.

Claim of Beneficial Use Map

Chemeketa Community College
 T.7S. R.2W. Sec. 7 and 18

Pacific Hydro-Geology Inc.