


SECTIONS 31 AND 32, TOWNSHIP 2 N., RANGE 14 E. W.M.
 WASCO COUNTY, OREGON

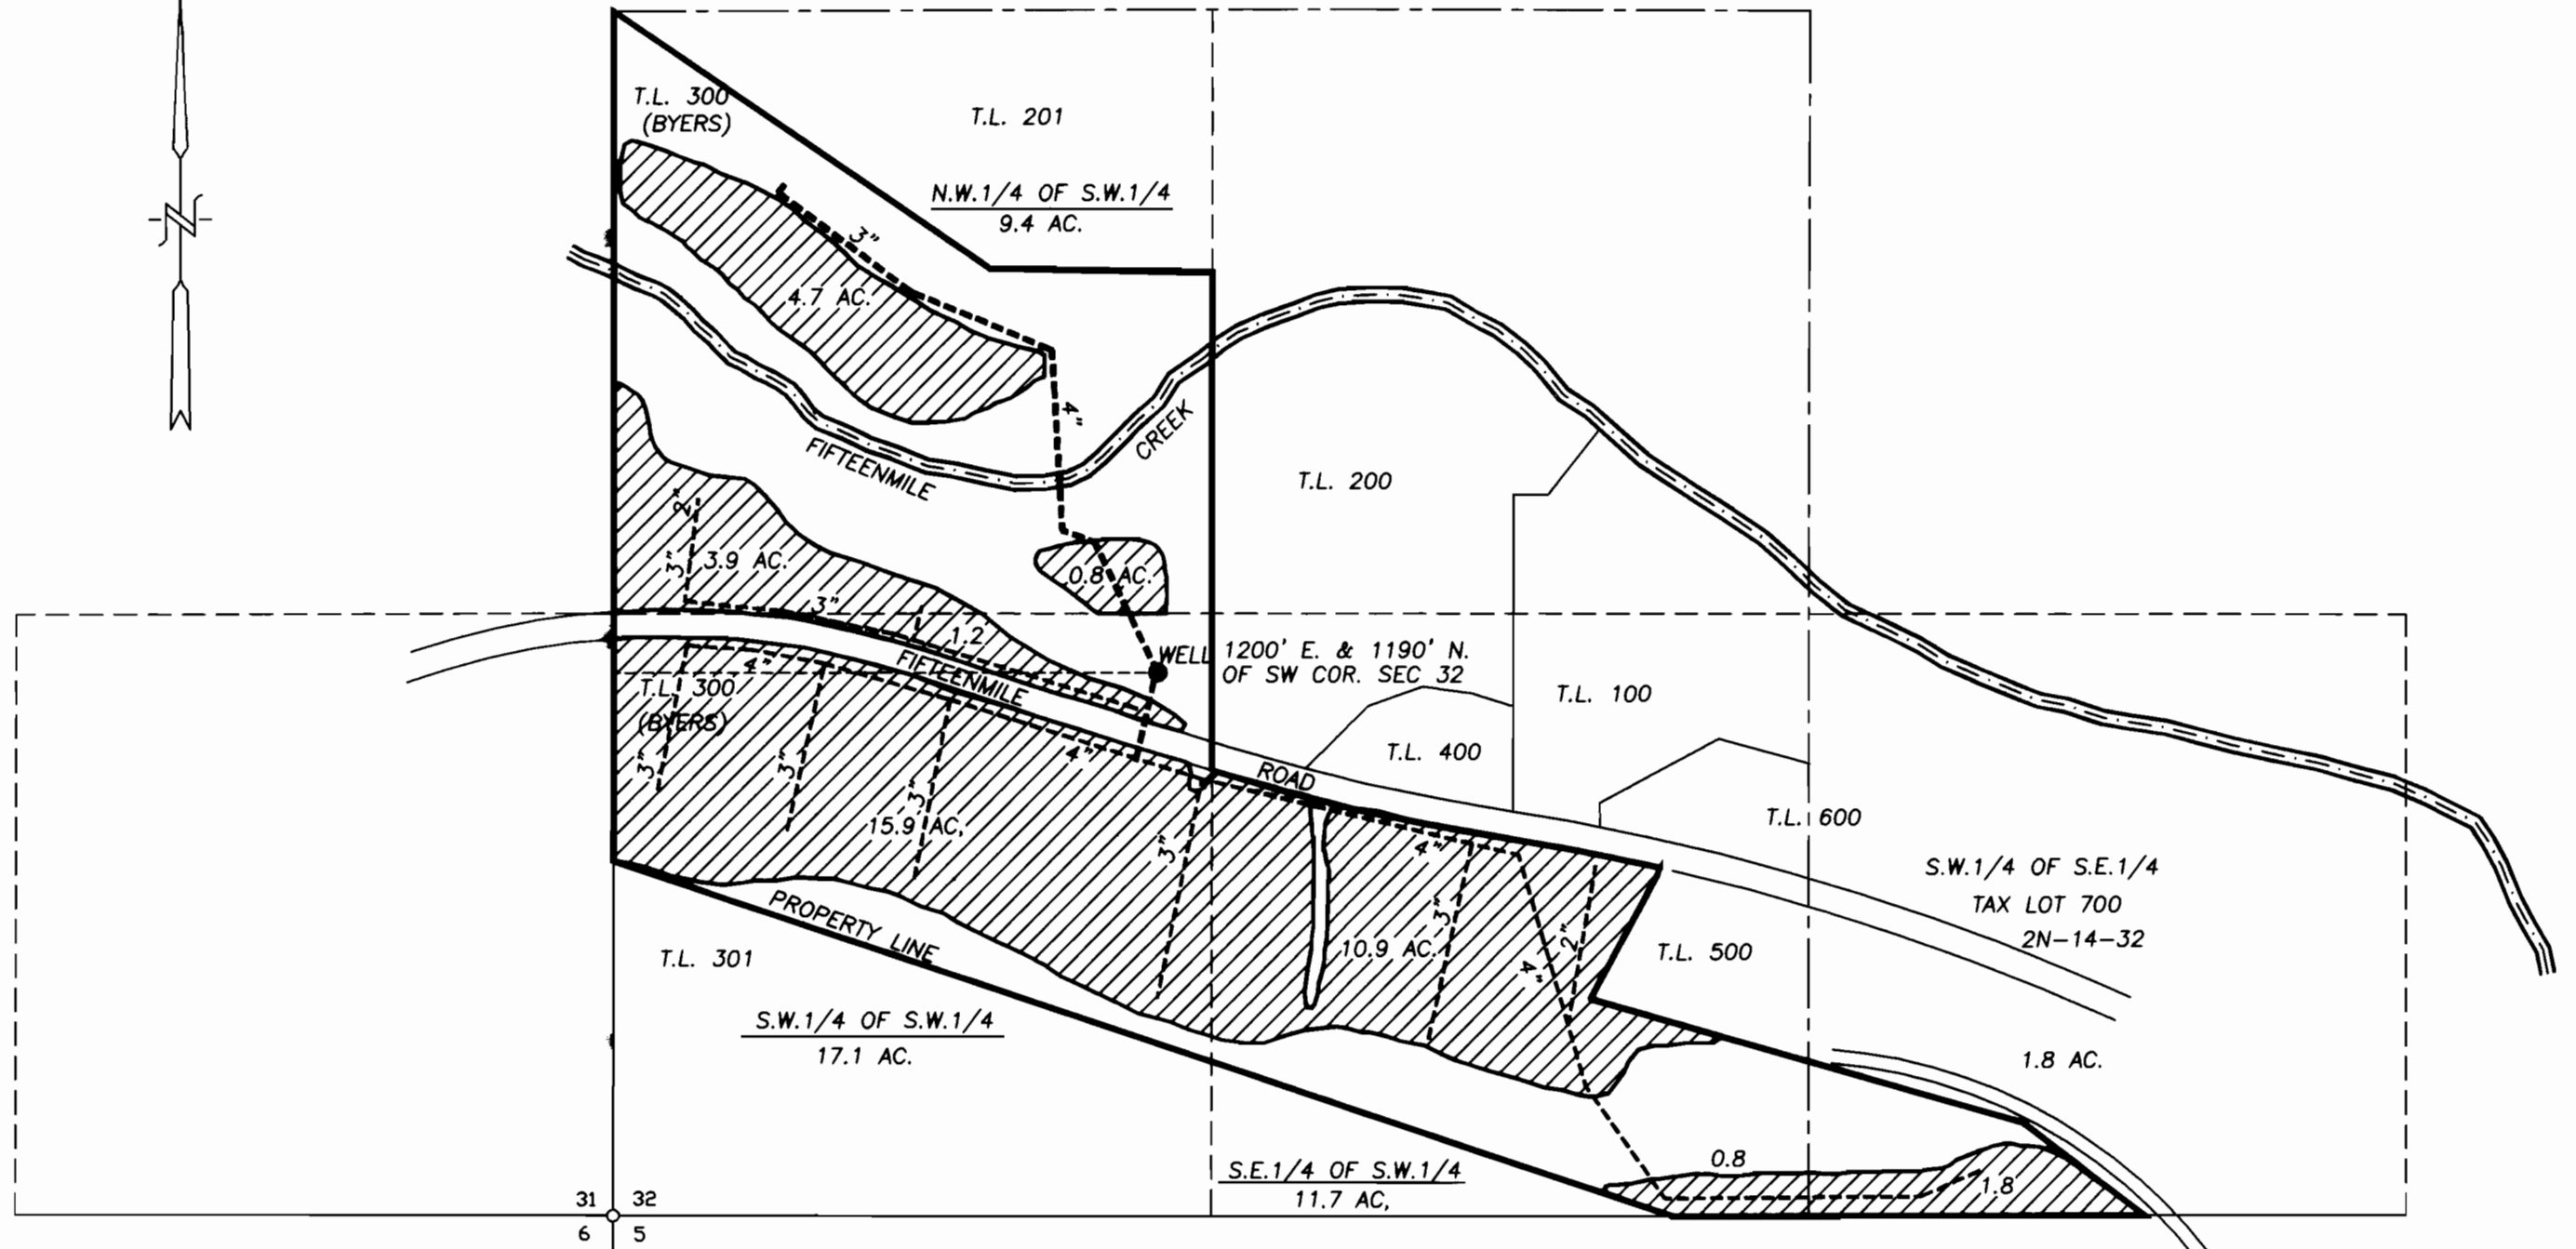

CERTIFICATE No. _____

PERMIT No. G-11336

IN THE NAME OF:
GENE T. BYERS

DATE: SEPTEMBER 25, 1996


WATER RIGHT FINAL PROOF SURVEY

SCALE: 1" = 400'

BY: TENNESON ENGINEERING CORP.
 409 LINCOLN STREET,
 THE DALLES, OREGON. 97058
 PH. 541-296-9177
 FAX 541-296-6657

NOTE:

"THIS MAP IDENTIFIES THE LOCATION OF THE WATER RIGHT ONLY AND IS NOT INTENDED TO PROVIDE DIMENSIONS OR LOCATE PROPERTY OWNERSHIP LINES."

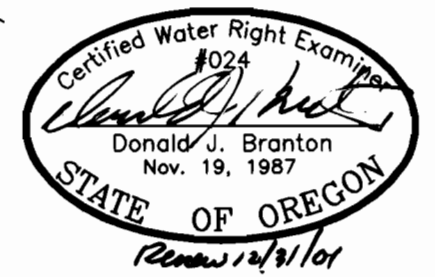

5/26/2000—REVISE ACREAGE (9.4 AC.) IN NW.1/4 OF SW.1/4

W.O. #7231