


T.4S., R.1W., W.M.

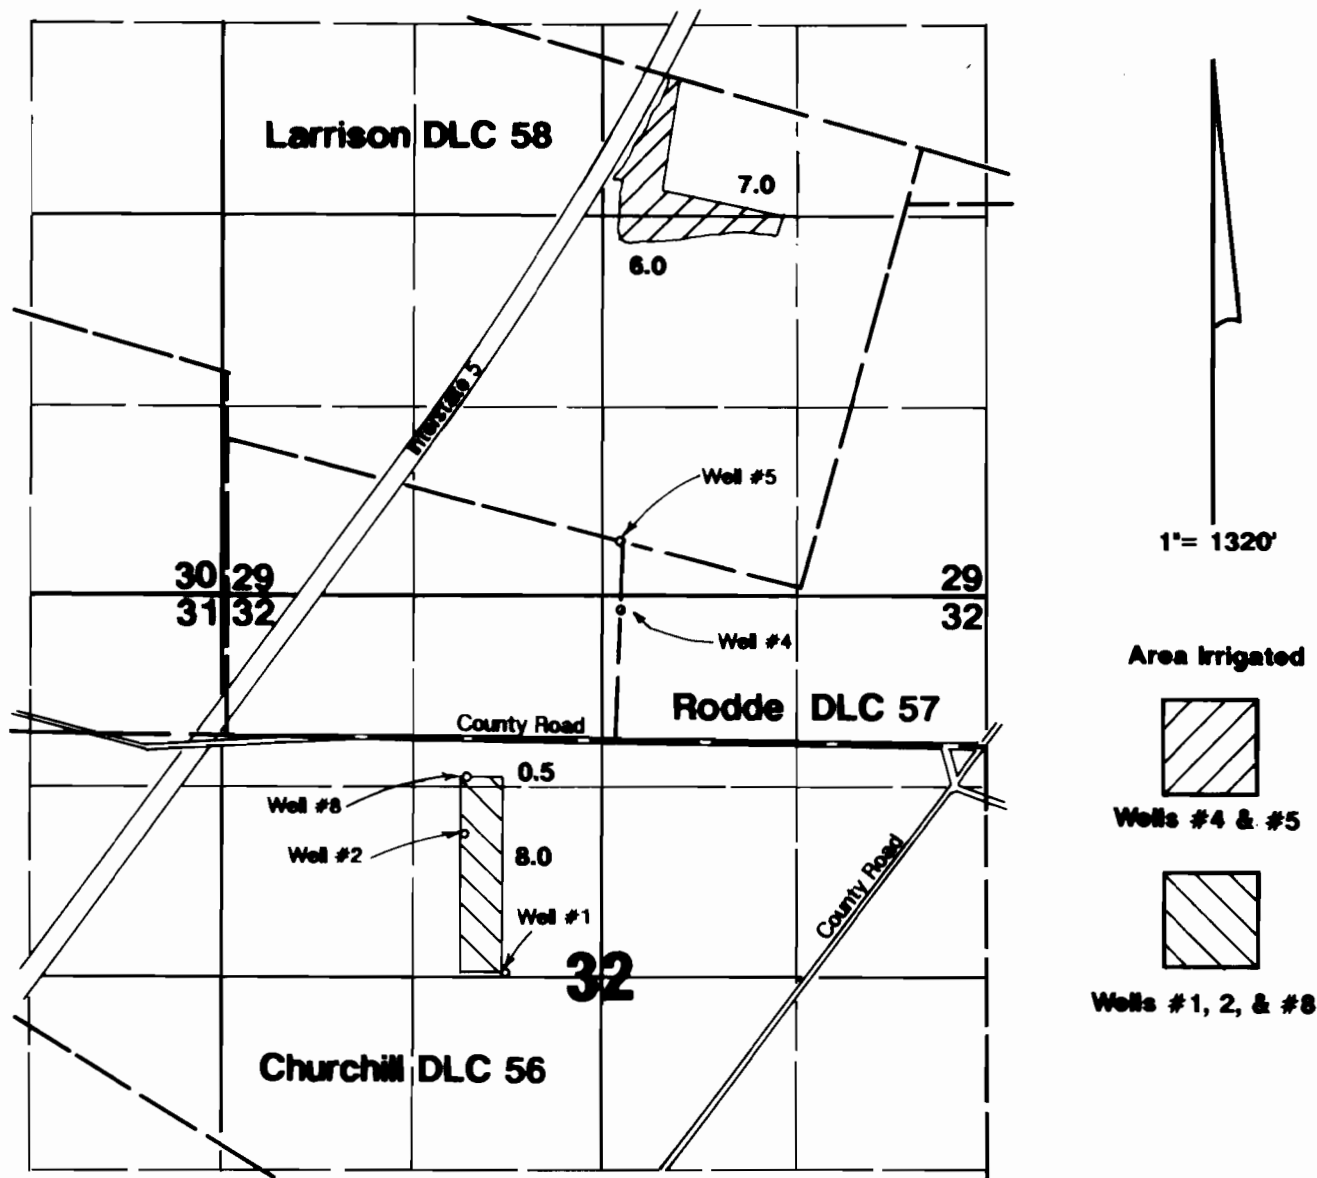

Well #1 located 60'N & 1950'E from W $\frac{1}{4}$ corner Section 32.
Well #2 located 980'N & 1650'E from W $\frac{1}{4}$ corner Section 32.
Well #4 located 70'S & 2750'E from NW corner Section 32.
Well #5 located 370'N & 2750'E from NW corner Section 32.
Well #8 located 1380'N & 920'W from center Section 32.


Final Proof Survey

Application #G-12275 Permit #G-11355

In Name Of

Tom DeArmond

Surveyed on October 6, 1994 by JM Schuetts

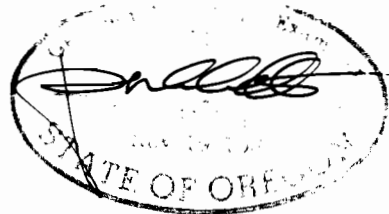

THIS MAP WAS PREPARED FOR THE PURPOSE OF IDENTIFYING THE LOCATION OF A WATER RIGHT ONLY AND IS NOT INTENDED TO PROVIDE LEGAL DIMENSIONS OR LOCATION OF PROPERTY OWNERSHIP LINES.