
T.9S., R.4W., W.M.

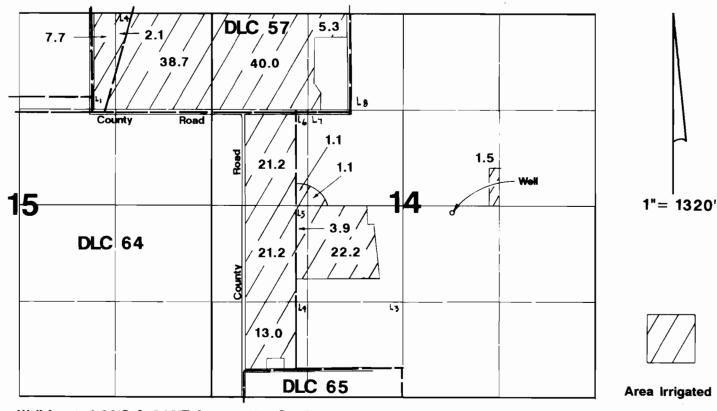

Well located 80'S & 640'E from center Section 14.

Final Proof Survey

Application # G-12328

Permit # G-11357

In Name Of

Dennis King

Surveyed on July 22, 1992 by Jim Grimm

James Grimm