

FINAL PROOF SURVEY

SITUATED IN THE SE1/4 SW1/4 OF SECTION 34,
T38S, R9EWM, KLAMATH COUNTY,
OREGON

SURVEYED: JULY, 2000

APPLICATION #G-12348
PERMIT #G-11359

TAX LOT
3809 34CD 5500

WELL LOCATION


375 FEET SOUTH AND 370 FEET WEST FROM
NE CORNER OF SE1/4 SW1/4, SECTION 34

RE-INJECTION WELL LOCATION

590 FEET SOUTH AND 615 FEET WEST FROM
NE CORNER OF SE1/4 SW1/4 SECTION 34

MAP PREPARED FOR
LEWIS M. & JUDITH L.
DODSON

MAP PREPARED FROM
— — APPLICATION MAP — —
— — FIELD SURVEY — —

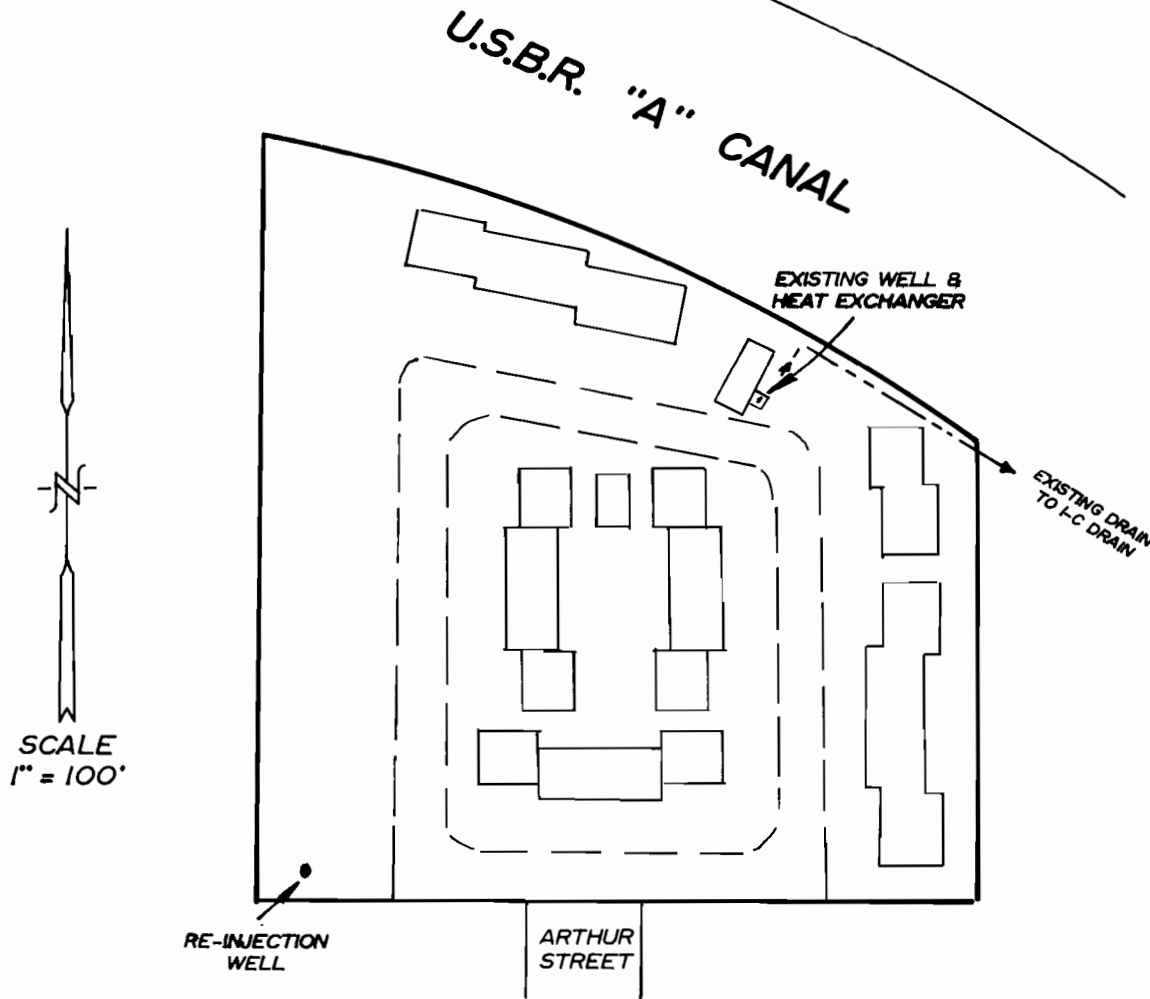

THE PURPOSE OF THIS MAP IS TO IDENTIFY THE LOCATION OF
THE WATER RIGHT. IT IS NOT INTENDED TO PROVIDE
INFORMATION RELATIVE TO THE LOCATION OF PROPERTY
OWNERSHIP BOUNDARY LINES.

TRU-LINE SURVEYING, INC.
2333 SUMMERS LANE
KLAMATH FALLS, OREGON 97603