
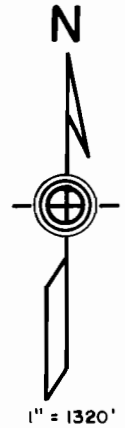


Township 6 & 7 South, Range 1 West, W.M.

A Portion of Section 32 in Township 6 South
and Section 5 in Township 7 South

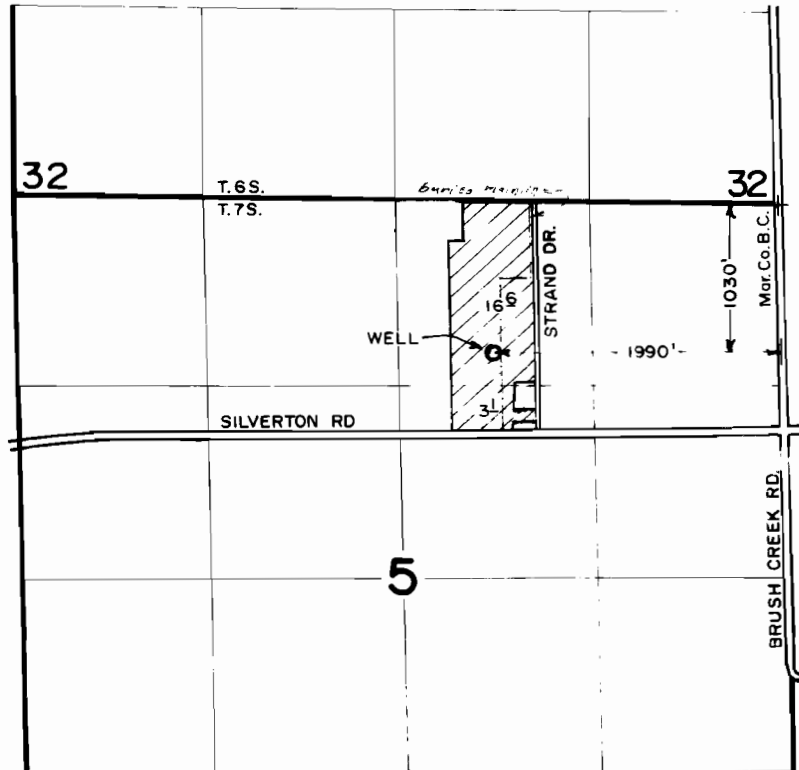


FINAL PROOF SURVEY
under

Appl. No. G-12363, Per. No. G-11370
in name of

GARRY BEAN
Sept. 14, 1995

RECEIVED

RECEIVED
JUN 15 1995

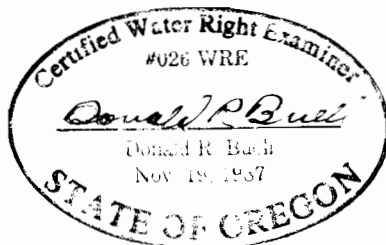

THIS MAP WAS PREPARED FOR THE PURPOSE OF IDENTIFYING THE LOCATION OF A WATER RIGHT ONLY AND IS NOT INTENDED TO PROVIDE LEGAL DIMENSIONS OR LOCATION OF PROPERTY OWNERSHIP LINES.