




Claim of Beneficial Use Map
for
AVION WATER CO.

Application G-11741
Permit G-11389

Surveyed March 10, 2000

Base map furnished by
Avion Water Company
GIS Department
3/2000 Drawn by DLR

This map is for the purpose of
locating a water right only
and has no intent to provide
legal dimensions or the location
of property lines.

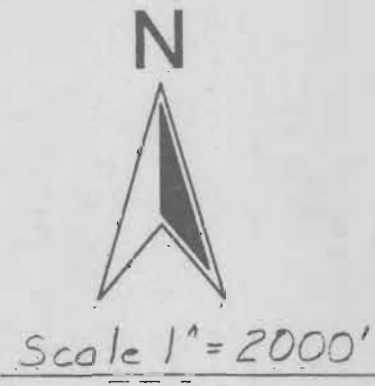

ESTES SURVEYS
PO Box 17519 60382 Arnold Rd
Salem, OR 97305-7519 Bend, OR 97702
(503) 585-7593 (541) 352-7391