


T. 6 S., R. 1 W., W. M.

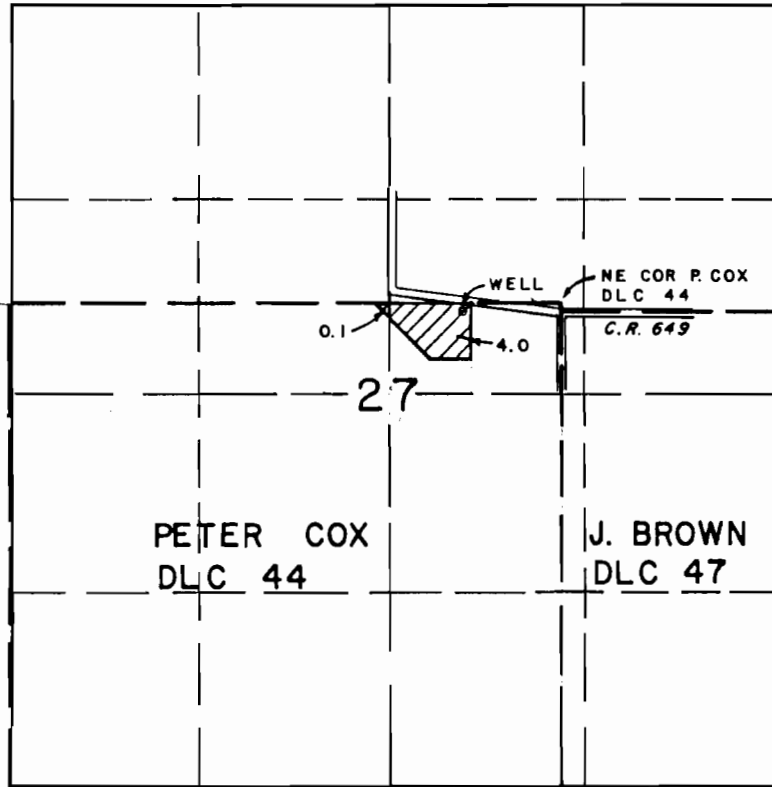

4" = 1 MILE




WELL LOC. 760' W. & 60' S. FROM NE COR. P. COX DLC 44

APPL. NO. G-12379 PER. NO. G-11395  
FINAL PROOF  
WATER RIGHT MAP FOR

ST. PAUL CEMETERY TRUST

SURVEYED ON DECEMBER 17, 1990

BY :

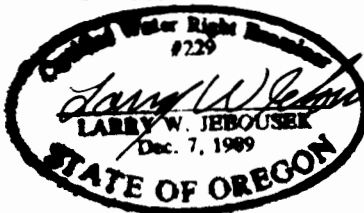

THIS MAP WAS PREPARED FOR THE PURPOSE OF IDENTIFYING THE LOCATION OF A WATER RIGHT ONLY AND IS NOT INTENDED TO PROVIDE LEGAL DIMENSIONS OR LOCATION OF PROPERTY OWNERSHIP LINES.

Inspected Aug. 9, 1995 *[Signature]*