

SECTION 31, TWP.2 N. RANGE 13 E. W.M.

WASCO COUNTY, OREGON

N.1/4

30 29  
31 32

SECTION CORNER

NOV 13 1997

WATER RESOURCES DEPT  
SALAM, OREGON

N. W. 1 / 4, N. E. 1 / 4

N. E. 1 / 4, N. E. 1 / 4

NC TYPED WELLS #1 & #3 NOT DEVELOPED

SHOULD BE WELLS #1 & #3

EXIST. WELL #3  
CAPPED.

S. W. 1 / 4, N. E. 1 / 4  
7.0 AC.

EXIST. WELL #2  
ELEV. 835'± MSL  
N.315.23' & W.2155.60  
FROM E.1/4, SEC. 31

S. E. 1 / 4, N. E. 1 / 4

140' EXIST. ROAD  
2155.60'

EXIST. WELL #3  
CAPPED.

C.1/4 COR.  
SEC. 31

E.1/4 CORNER  
14"x14"x20" STONE  
"W.1/4" ON FACE.

PLANTED ORCHARD  
AREA. 2.4 AC±

PASTURE AREA  
4.6 AC±

TOTAL AREA= 7.0 AC.

WATER RIGHT FINAL PROOF SURVEY

SCALE: 1"= 400'

CERTIFICATE No. G-12452


PERMIT No. G-11399

IN THE NAME OF:

JAMES & LORETTA ELLETT, H.&W.

DATE: SEPTEMBER 27, 1997

BY: TENNESON ENGINEERING CORP.  
409 LINCOLN STREET,  
THE DALLES, OREGON. 97058  
PH. 541-296-9177  
FAX 541-296-6657

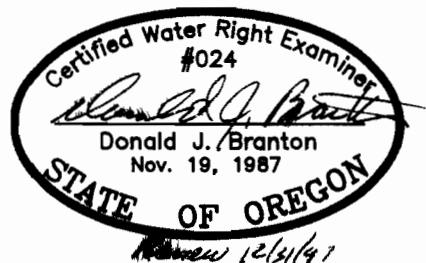

NOTE:

"THIS MAP IDENTIFIES THE LOCATION OF THE WATER RIGHT ONLY AND IS NOT INTENDED TO PROVIDE DIMENSIONS OR LOCATE PROPERTY OWNERSHIP LINES."

W.O. #7382