

T 37 S, R 2 W, W.M.
Section 32
Jackson County, Oregon


RECEIVED

SEP 2 1995

WATER RESOURCES DEPT.
SALEM, OREGON

FINAL PROOF SURVEY
UNDER

Application G - 12406 Permit G-11409

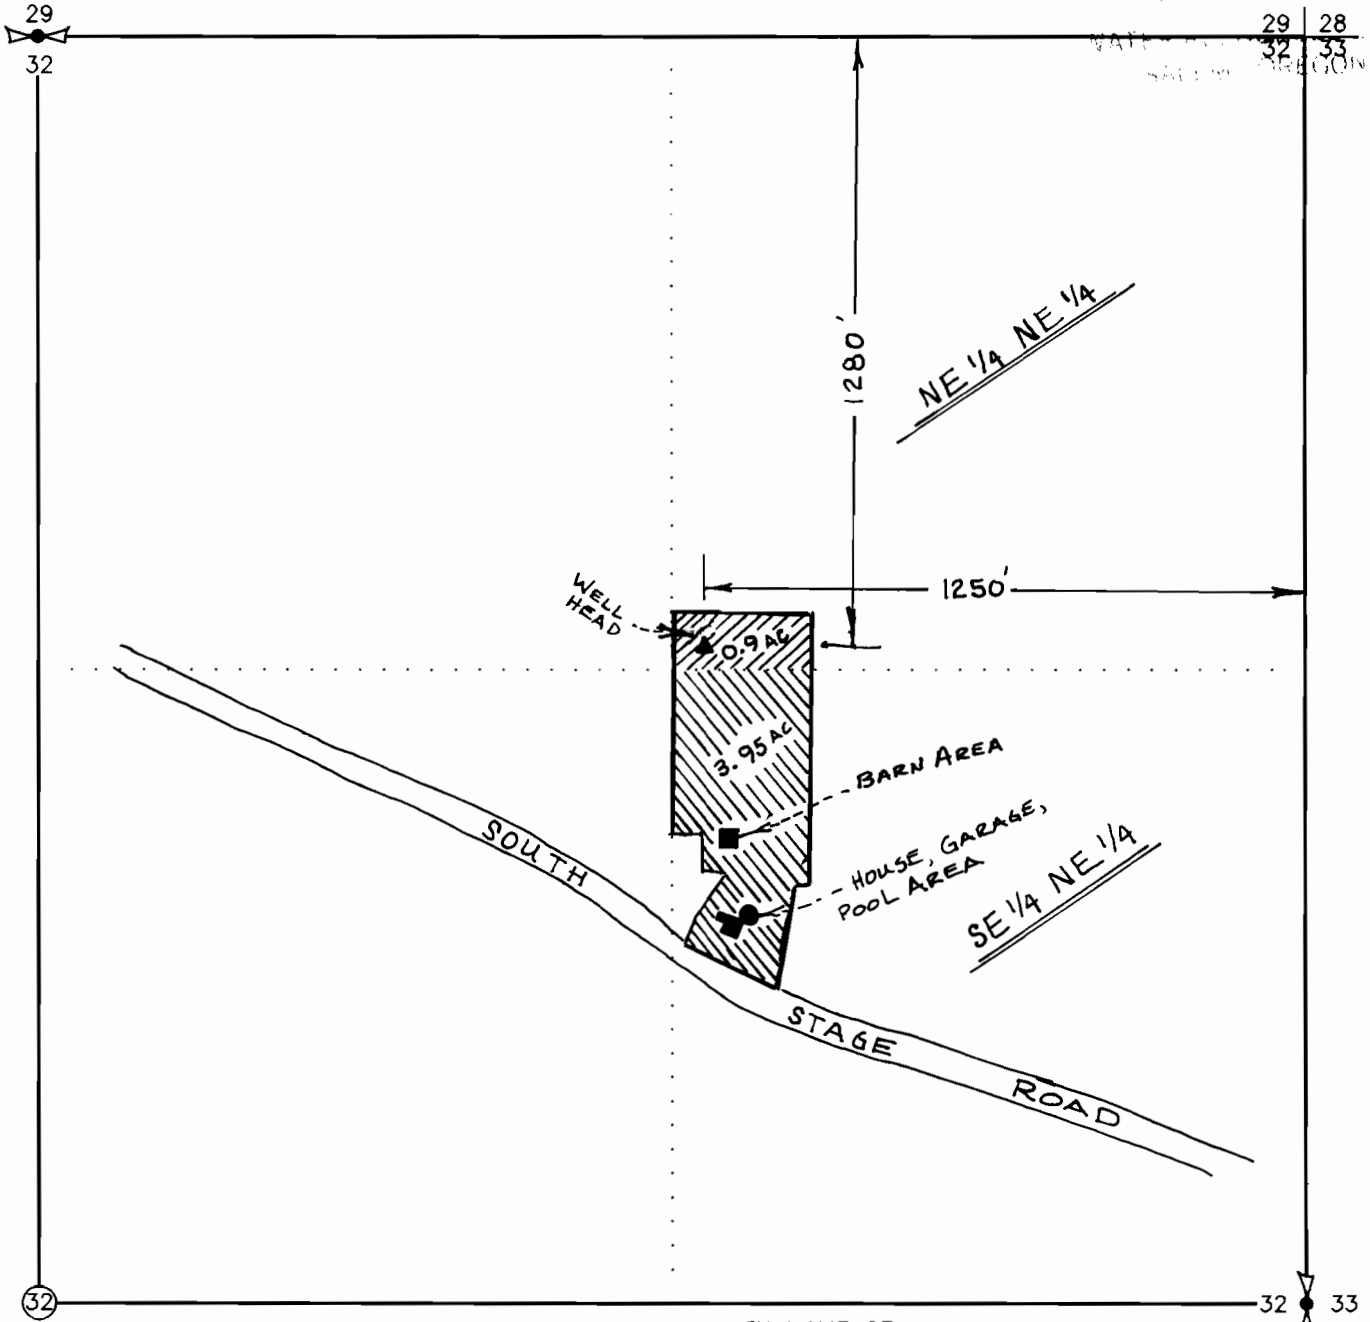

IN NAME OF: MARIETTE MARMILLOD
755 E. CALIFORNIA ST.
JACKSONVILLE, OR. 97530

Surveyed August 28, 1995
by Richard L. Bath

Richard L. Bath
CWRE No. 013

Certified Water Right Examiner
013
Richard L. Bath
Richard L. Bath
Nov 19, 1987
STATE OF OREGON
Exp. 12-31-95

N
SCALE 1" = 400'