

T. 2N., R. 31E., W.M.


UMATILLA COUNTY

SCALE 1" = 1320'

RECEIVED

SEP 30 1996

WATER RESOURCES DEPT
SALEM, OREGON

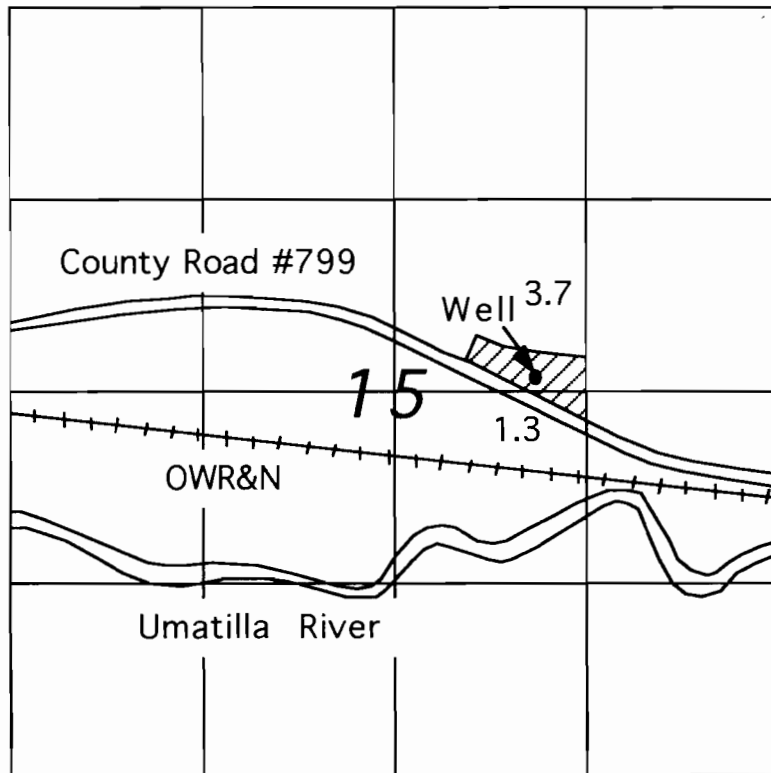

Well Located 150' North & 875' East of Center 1/4 of Section 15

WATER RIGHTS PROOF MAP



Water Rights Found At This Location


IN NAME OF

Robert Forth

Application #G-12464

Permit #G-11412

THIS MAP IS FOR THE PURPOSE
OF IDENTIFYING THE LOCATION
OF WATER RIGHTS ONLY AND IS
NOT INTENDED TO PROVIDE THE
LEGAL DIMENSIONS OR LOCATIONS
OF PROPERTY OWNERSHIP LINES.

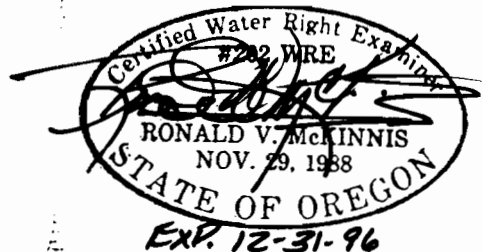

ENGINEERING - SURVEYING - WATER RIGHTS

R V MCKINNIS ENGINEERING

Rt 1 Box 1122 Hermiston, Oregon 97838

503-567-2017