


T.4 S.R.2W. W.M.

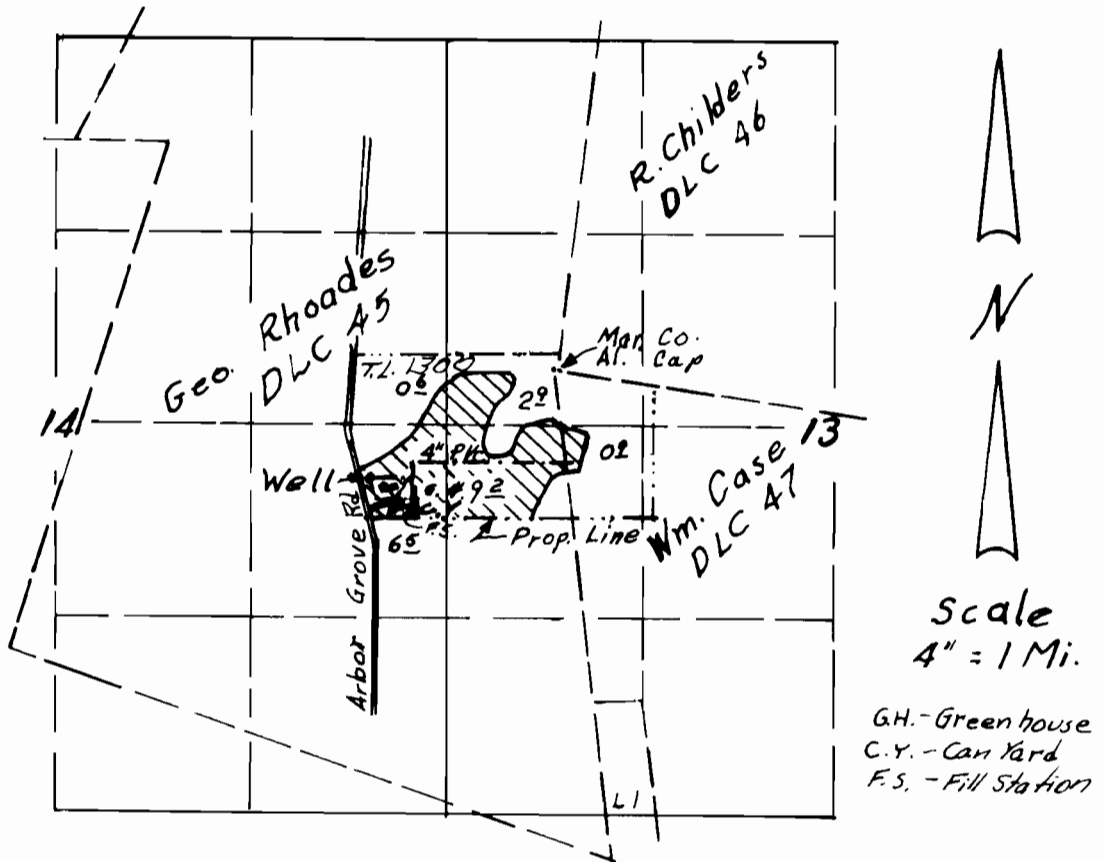

Scale
4" = 1 Mi.

G.H. - Green house
C.Y. - Can Yard
F.S. - Fill Station

Well loc. 720' S & 1320' W from SW Cor DLC 46

FINAL PROOF SURVEY UNDER
Appl. No. G-12435 Permit No. G-11427 For
STEVE CATTS

THIS MAP WAS PREPARED FOR THE PURPOSE OF IDENTIFYING THE LOCATION OF A WATER RIGHT ONLY AND IS NOT INTENDED TO PROVIDE LEGAL DIMENSIONS OR LOCATION OF PROPERTY OWNERSHIP LINES.

