

SECTION 12 & 13, T.1N. R.2W., W.M.
WASHINGTON COUNTY, OREGON.



SCALE: 1" = 400'

MAP BASE:
1933 WAC PHOTO
ASSESSORS MAP

RECEIVED

SEP 25 1995

WATER RESOURCES DEPT.
SALEM, OREGON

WEST LINE JOHN C. ZACHARY
DLC 66

T.L. 2400

1270'

WELL

4" DIA. PVC
MAINLINE

630'

11 12

14

13

T.L. 600

23.5 Ac.

CORNELIUS
PASS
ROAD


0.5 Ac.

PREPARATION OF THIS MAP IS FOR THE
PURPOSE OF IDENTIFYING THE LOCATION OF
TO PROVE DIVISIONS OR LOCATIONS OF
PROPERTY CORNELLUS LINES

FINAL PROOF SURVEY

SURVEYED AUGUST 7, 1995

APPLICATION G-12717 PERMIT G-11436

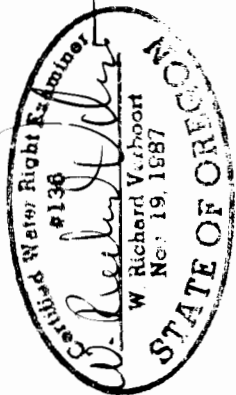

VERBOORT ENGINEERING
AGRICULTURE • CIVIL • WATER RESOURCES
HILLSBORO, OREGON

	by	date
designed	WRV	8.95
drawn	JER	8.95
checked	WRV	8.95
drawing no.	B-11-95	
sheet no.	1/1	

JEFF BODEN
7775 NW CORNELIUS PASS RD.
HILLSBORO, OR 97124