FINAL PROOF

Application No.
G-12053
Permit No. G-11440
In Name Of
Fred Reichow

Present Use
SE1/4 NE1/4
Permit No. 2-1711
38.00 acres

Permit No. G-906
38.00 acres

Old well 1920' S
and 55' E of
NE corner S30

New well 1970' S
and 867' E of
NE corner S30

T.6N., R.35E., W.M.

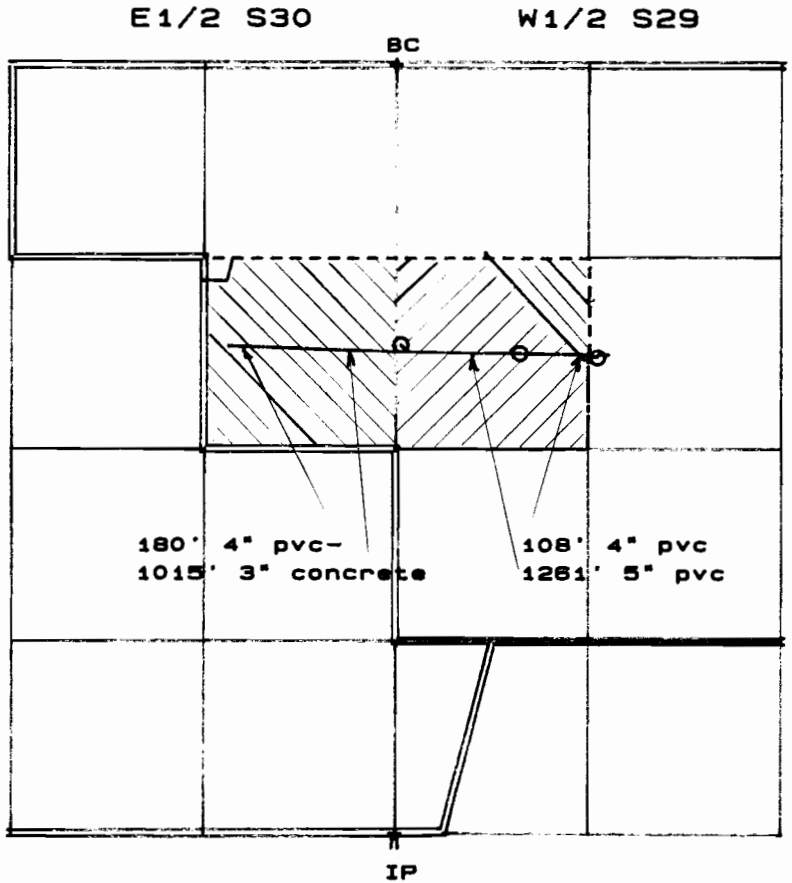

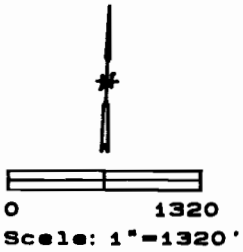

Present Use
SW1/4 NW1/4
Permit No. 2-1274
34.80 acres

Permit No. U-701
5.74 acres

Ditch intake
1994' S and
1402' E of
NE corner S30

Certified Water Right Examiner
#309
David L. Haddock
David L. Haddock
Nov. 19, 1991
STATE OF OREGON

Owner:
Mr. Fred Reichow
Route 1, Box 33
Milton-Freewater,
OR 97862
(503) 938-5806

Survey By:
CWRE 300
(renews 6-30-95)
David Haddock
P. O. Box 1574
Pendleton, OR 97801
(503) 276-2193
Date: September, 1994
Equipment:
Wild System 200 GPS

NOTE:
The information shown on this map is solely for Water Rights purposes. The data shown does not represent ownership information.