



T.7S., R.2W., W.M.

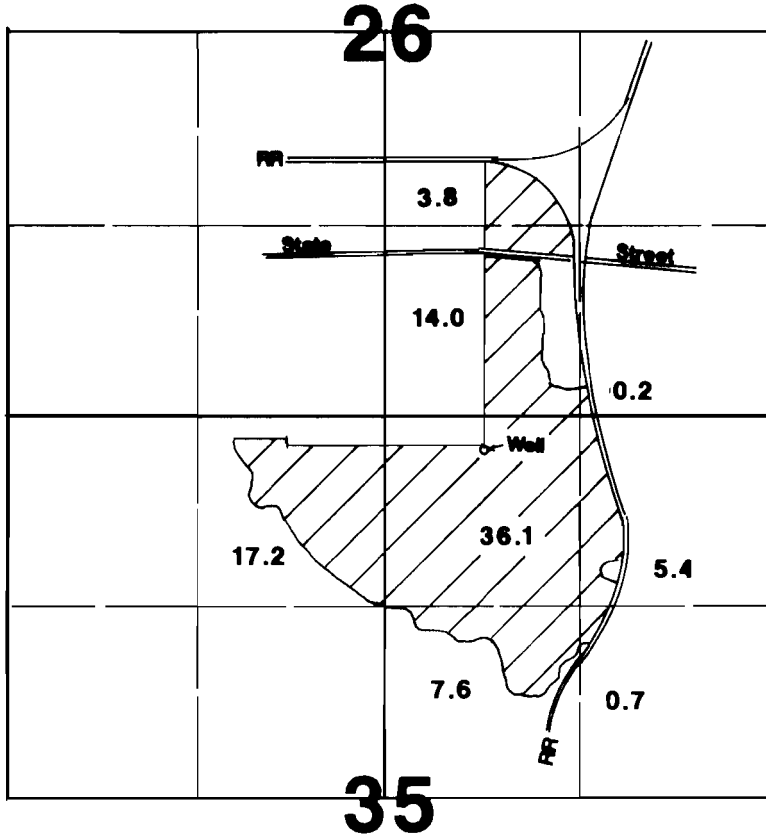

Well located 230'S & 1980'W from NE corner Section 35.

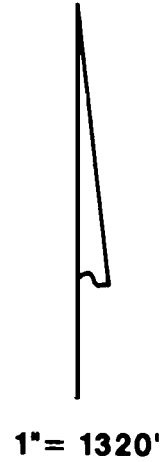

RECEIVED

JUN 13 1995

WATER RESOURCES DEPT
SALEM, OREGON

Final Proof Survey

Application #: G-12242 Permit #: G-11448

In Name Of

Cecil E. Roth

Surveyed on May 22, 1995 by JM Schuette

THIS MAP WAS PREPARED FOR THE PURPOSE OF IDENTIFYING THE LOCATION OF A WATER RIGHT ONLY AND IS NOT INTENDED TO PROVIDE LEGAL DIMENSIONS OR LOCATION OF PROPERTY OWNERSHIP LINES.

