


Township 5 South, Range 1 West, W. M.
Section 35

RECEIVED

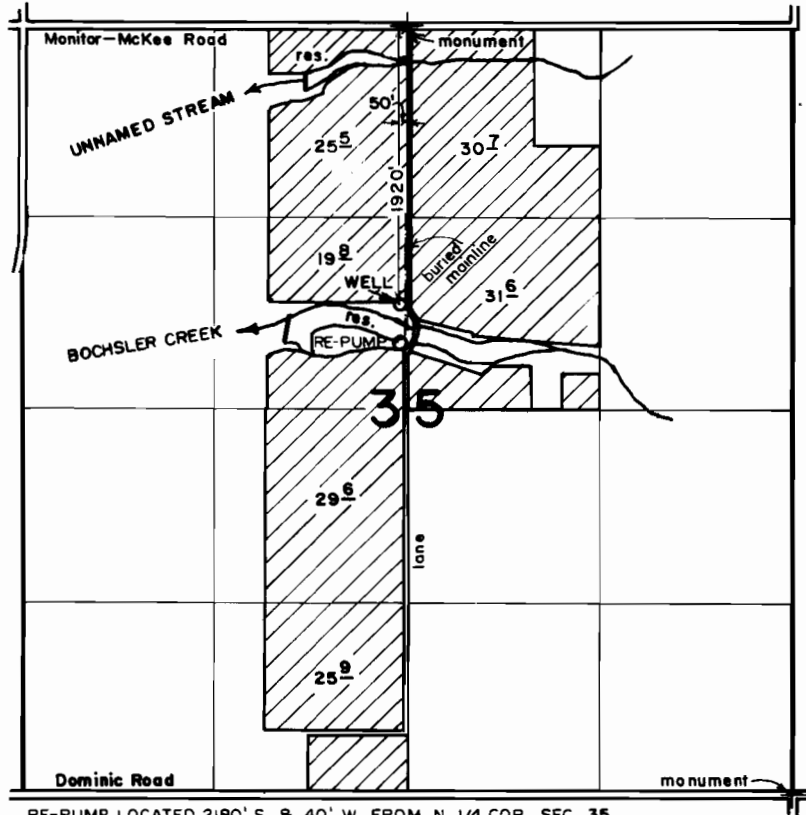

RE-PUMP LOCATED 2180' S. & 40' W. FROM N. 1/4 COR. SEC. 35.

FINAL PROOF SURVEY


under

Appl. No. G-12129, Per. No. G-11454

in name of

RON VANDECOEVERING

Jan. 23, 1996

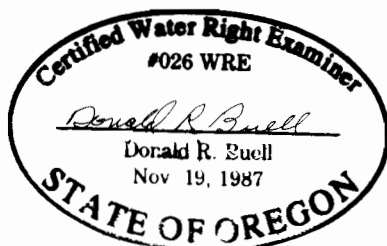

THIS MAP WAS PREPARED FOR THE PURPOSE OF IDENTIFYING THE LOCATION OF A WATER RIGHT ONLY AND IS NOT INTENDED TO PROVIDE LEGAL DIMENSIONS OR LOCATION OF PROPERTY OWNERSHIP LINES.