



T.5S., R.4W., W.M.

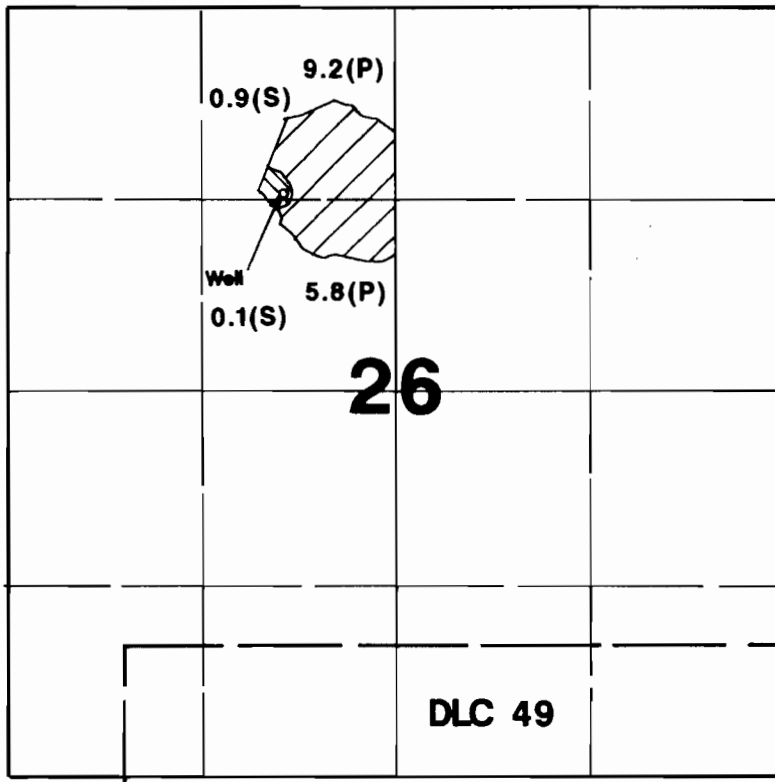

Well located 1300'S & 1880'E from NW corner of Section 26.



Area Irrigated

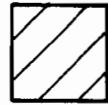

Primary



Supplemental

Final Proof Survey

Application #: G-12374 Permit #: G-11491

In Name Of

Fred & E. Diane Zeitoun

Surveyed on October 4, 1995 by JM Grimm



THIS MAP WAS PREPARED FOR THE PURPOSE OF IDENTIFYING THE LOCATION OF A WATER RIGHT ONLY AND IS NOT INTENDED TO PROVIDE LEGAL DIMENSIONS OR LOCATION OF PROPERTY OWNERSHIP LINES.