


T.4S.,R.1E.,W.M.

SECTION 29

RECEIVED

NOV 7 1995


PLAT NO. 2021
2028

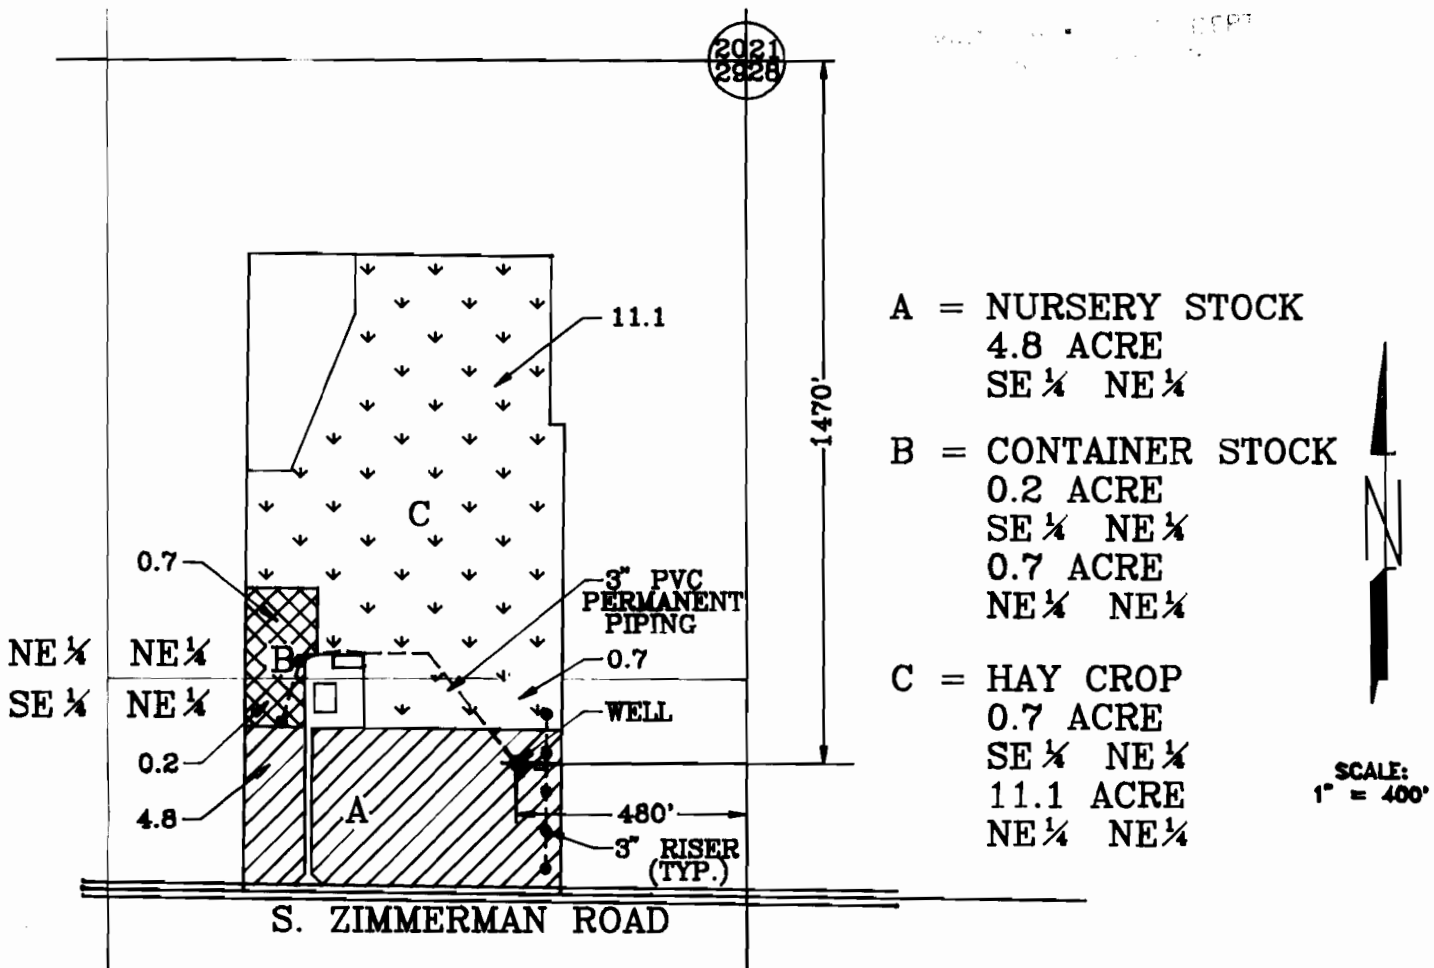

- A = NURSERY STOCK
4.8 ACRE
SE ¼ NE ¼
- B = CONTAINER STOCK
0.2 ACRE
SE ¼ NE ¼
0.7 ACRE
NE ¼ NE ¼
- C = HAY CROP
0.7 ACRE
SE ¼ NE ¼
11.1 ACRE
NE ¼ NE ¼

FINAL PROOF SURVEY

UNDER APPLICATION NO. G-12738 PERMIT NO. G-11495
 IN THE NAME OF
 JENNIFER L. WARD
 Canby, Oregon
 SEPTEMBER 15, 1995

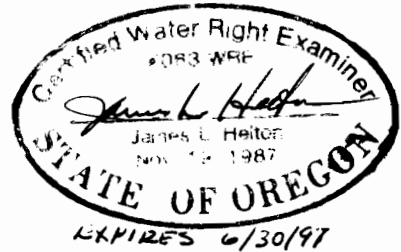

NOTE: This map is for the purpose of identifying the location of the water right only and is not intended to provide legal dimensions or locations of property lines.