


TOWNSHIP 16 SOUTH, RANGE 4 WEST, W.M.

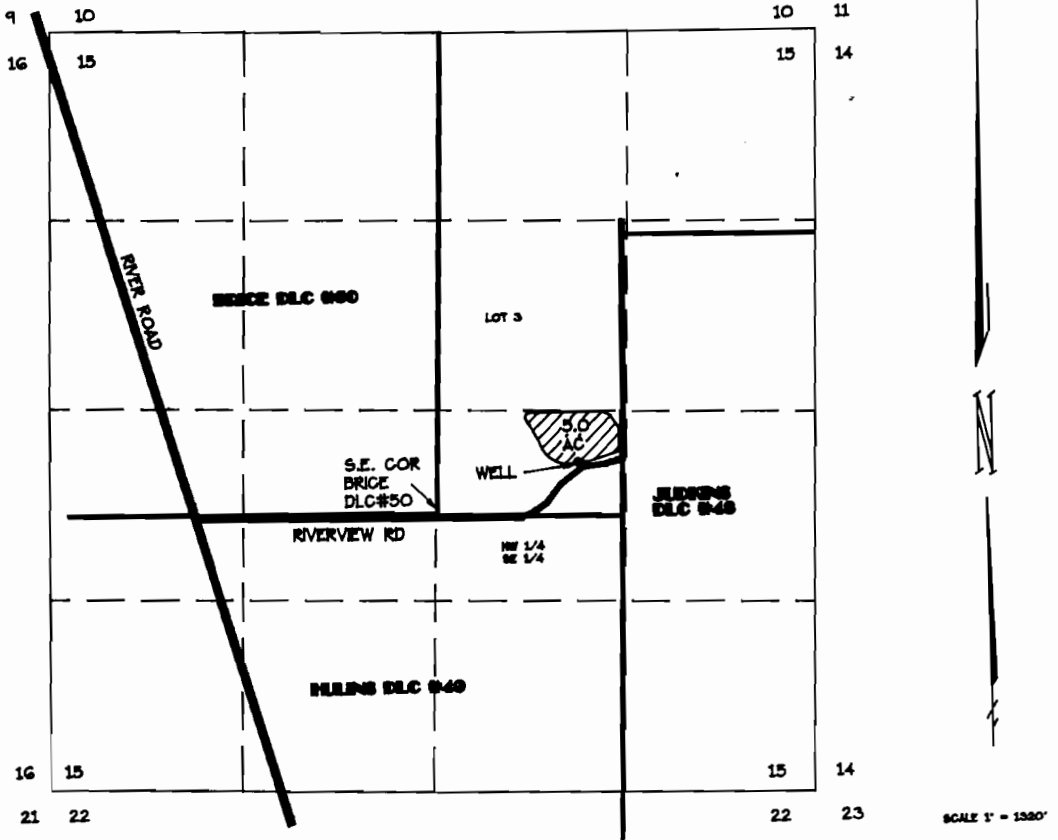

APP. #G12083 PERMIT #G11560

WELL LOCATION:


315.92 FEET NORTH + 999.23 FEET EAST OF THE S.E. CORNER OF THE BRICE DLC #50.



AREA OF FINAL PROOF

FINAL PROOF SURVEY
FOR
AUDREY FARVER
92901 RIVER ROAD
JUNCTION CITY, OREGON 97448
PH (503) 998-6465

BY
FORD - NESS - FASSBENDER
1120 BAILEY HILL RD #1
EUGENE, OREGON 97402
PH (503) 344-1852
NOVEMBER 15, 1994

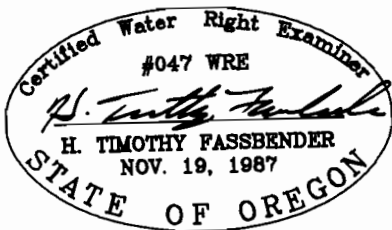

NOTE:
THIS MAP WAS PREPARED FOR THE PURPOSE OF IDENTIFYING THE LOCATION OF THE WATER RIGHT ONLY. IT IS NOT INTENDED TO PROVIDE DIMENSIONS OR LOCATION OF PROPERTY OWNERSHIP LINES.

JOB NO. 1052.03