


RECEIVED

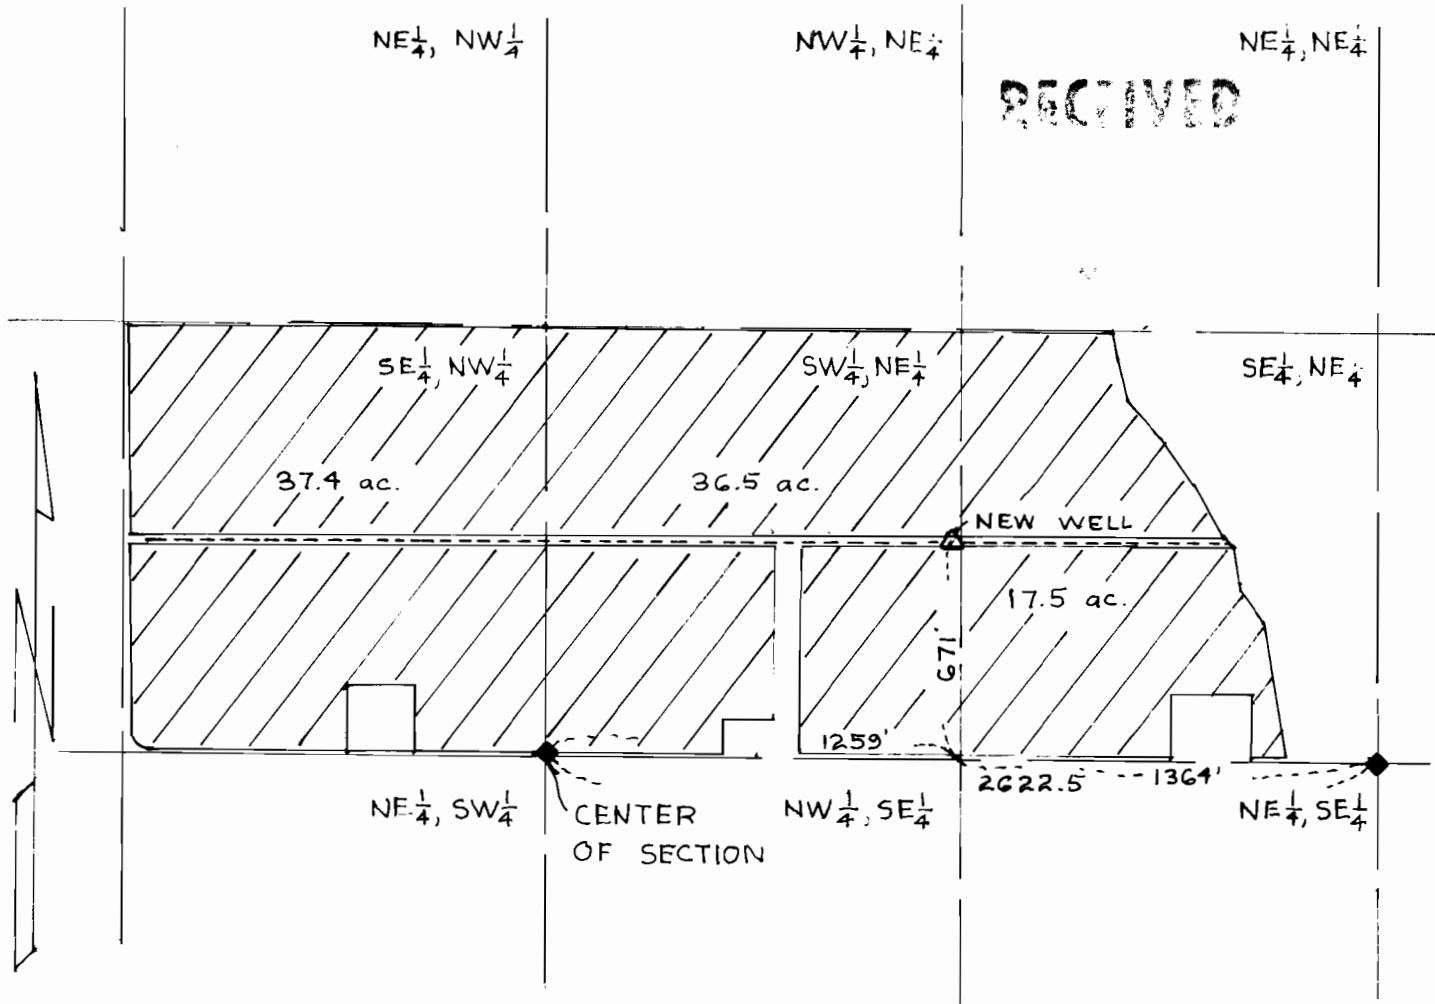

◆ FND RR SPIKE AS PER
C.S. 90-075C

PLAN OF THE WATER PIPING IS ON
FILE WITH OREGON WATER RESOURCES
LOAN DIVISION.

KRUMBEIN ENGINEERING LTD.
ENGINEERS - SURVEYORS - PLANNERS
361 S.E. Second Pendleton, Oregon

Scale
1"=600'
Date
10-25-93

Drn By
DHK
Ckd. By

Drng No
9316A
Job No.
8954

Revision 1
Revision 2

FINAL PROOF
STADELMAN FRUIT
N 1/2, SECTION 26
T.6 N., R. 35 E.W.M.



UNTIL 12/31/93

APPL. G-12008
PERMIT G-11575