


# T.4S., R.2W., W.M.

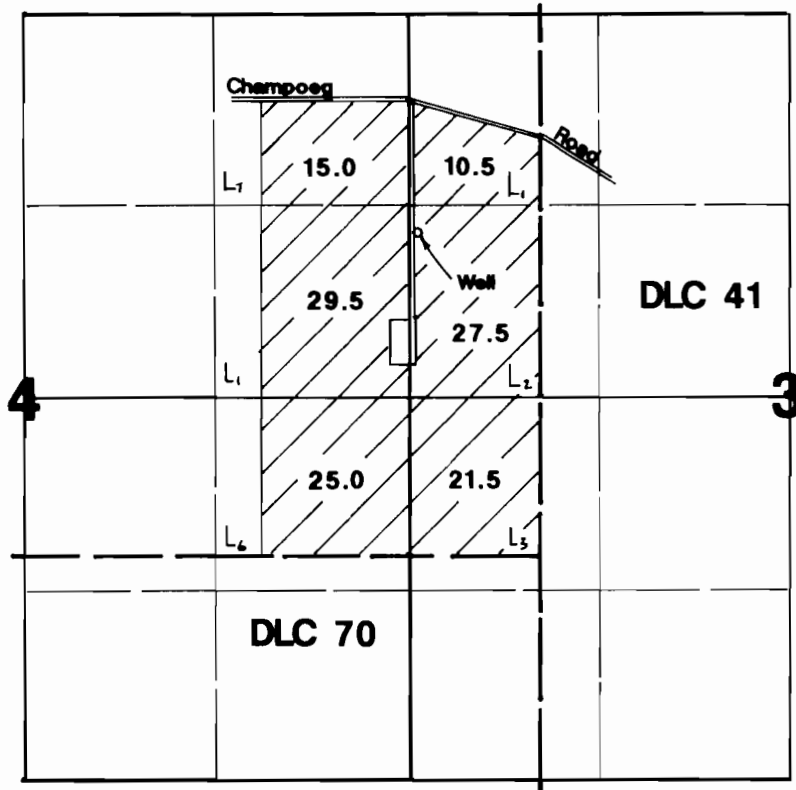

Well located 1150'N & 35'E from E $\frac{1}{4}$  corner of Section 4.

## Final Proof Survey

Application #: G-12487 Permit #: G-11589

In Name Of

# Maxine Rasmussen

Surveyed on October 27, 1994 by JM Schuette

THIS MAP WAS PREPARED FOR THE PURPOSE OF IDENTIFYING THE LOCATION OF A WATER RIGHT ONLY AND IS NOT INTENDED TO PROVIDE LEGAL DIMENSIONS OR LOCATION OF PROPERTY OWNERSHIP LINES.