


FINAL PROOF SURVEY MAP

IN THE NAME OF RODERICK FRASER II
SECTION 25, TOWNSHIP 29 SOUTH, RANGE 15 WEST, W.M.
APPLICATION G-12723 PERMIT G-11595

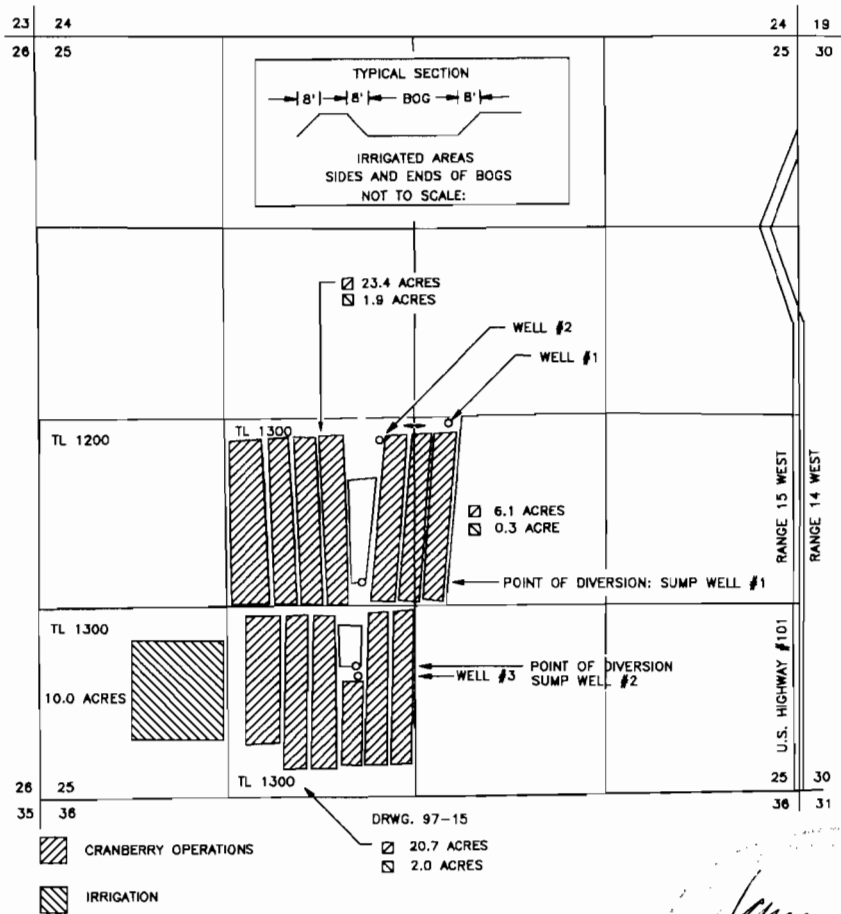

POINTS OF DIVERSION:

Sump Well #1: 1480 feet north and 2230 feet east, being within the NE1/4 SW1/4, **Sump Well #2:** 900 feet north and 2180 feet east, being within the SE1/4 SW1/4, **Well #1:** 2550 feet north and 2830 feet east, being within the NW1/4 SE1/4, **Well #2:** 2450 feet north and 2350 feet east, being within the NE1/4 SW1/4, **Well #3:** 820 feet north and 2200 feet east, being within the SE1/4 SW1/4, all from the southeast corner of Section 25, and all within Section 25, Township 29 South, Range 15 West, W.M., Coos County.

THE PURPOSE OF THIS MAP IS TO IDENTIFY THE LOCATION OF THE WATER RIGHT. IT IS NOT INTENDED TO PROVIDE INFORMATION RELATIVE TO THE LOCATION OF PROPERTY OWNERSHIP BOUNDARY LINES.