


TOWNSHIP 6 SOUTH, RANGE 1 EAST, W.M.

RECEIVED

OCT 27 1997

WATER RESOURCES DEPT.
SALEM, OREGON

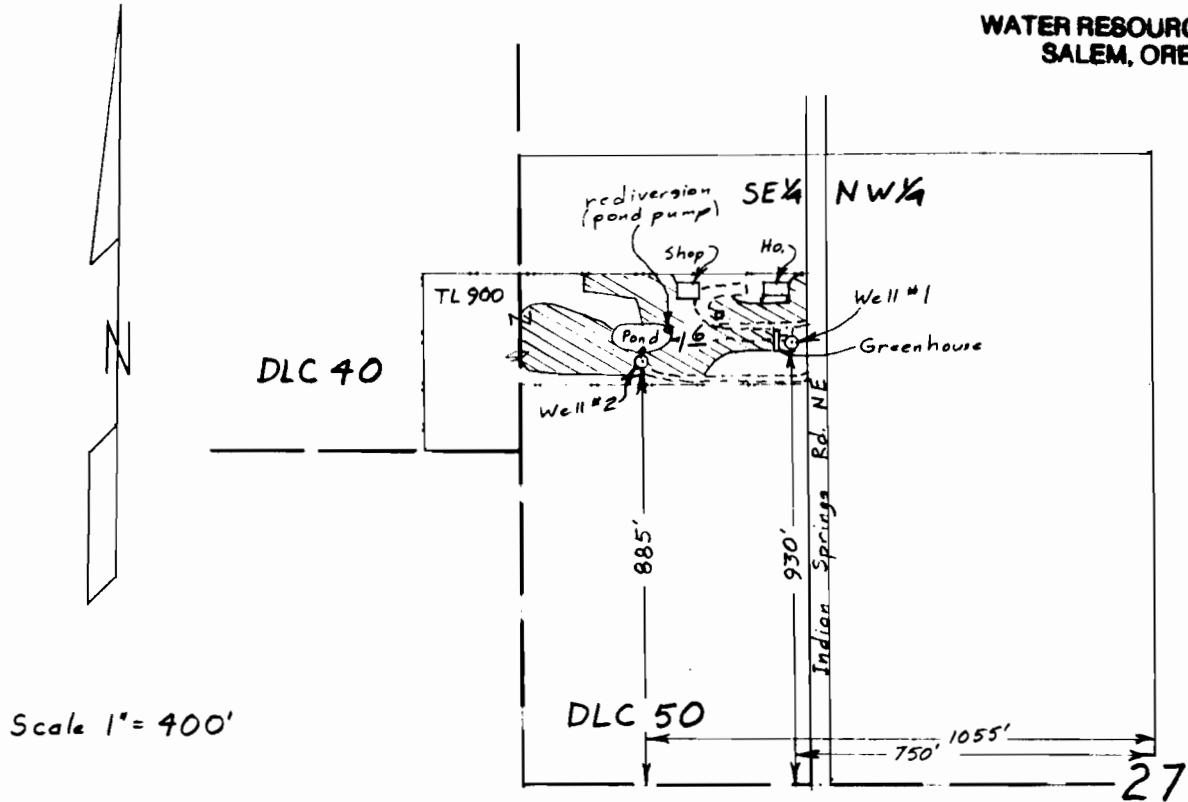


Surveyed September 27, 1997

Claim of Beneficial Use Map
for

JEFF & DEBRA McDONALD

App G-12691
Permit G-11610

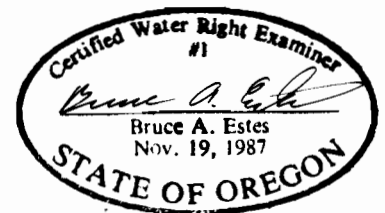

This map is for the purpose of
locating a water right only
and has no intent to provide
legal dimensions or the location
of property lines.

ESTES SURVEYS

6293 Sunnyview Rd. NE 60382 Arnold Rd.
Salem, OR 97305 Bend, OR 97702
(503) 585-7593 (503) 382-7391