



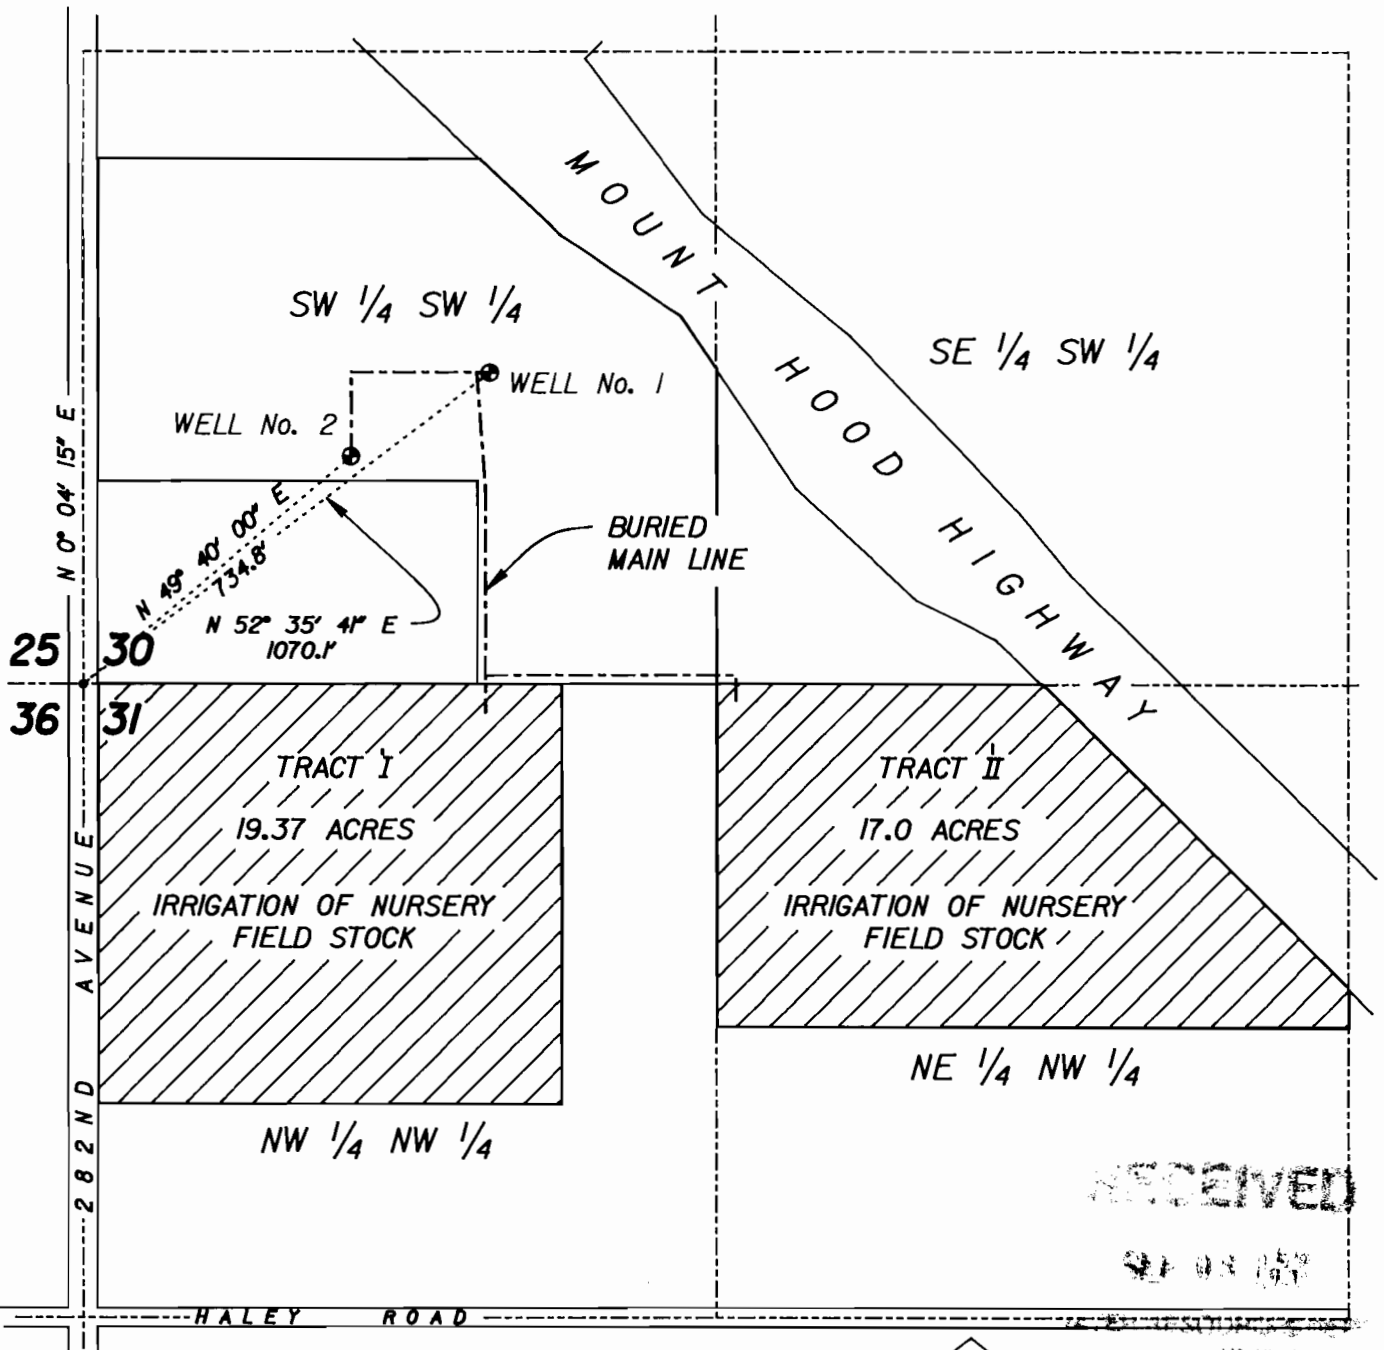

This drawing is a Final Proof Survey for a Ground Water Right. It is not a Land Survey. Property lines and/or other lines of occupation shown hereon are not represented by the undersigned to meet accuracy standards of Land Surveys.


SCALE: 1" = 400'

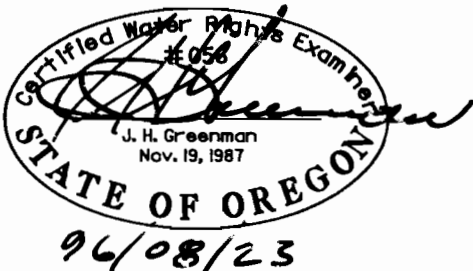

SECTIONS 30 & 31, T.1S., R.4E., W.M.
CLACKAMAS COUNTY, OREGON

Application No. **G-13272**

Permit No. **G-11611**

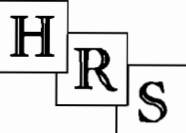

**HANER, ROSS &
SPORSEEN, INC.**

15 S.E. 82ND DRIVE
GLADSTONE, OREGON 97027

REARDON NURSERY INC.
GROUND WATER RIGHT
FINAL PROOF SURVEY

630DD