

SECTION 4, T. 3 S., R. 1 E., W.M.

S. W. 1/4 N. E. 1/4
Section 4

N. E. 1/4 S. W. 1/4
Section 4

N. W. 1/4 S. E. 1/4
Section 4

House
Buried Mainline

Barn
Well
Transmission Tower

WELL IS LOCATED 1290 FEET NORTH AND
65 FEET EAST OF THE SOUTH 1/4 CORNER
OF SECTION 4.

S. E. 1/4 S. W. 1/4
Section 4

S. W. 1/4 S. E. 1/4
Section 4

Area in S.W. 1/4 N.E. 1/4 = 0.9 Acres
Area in N.W. 1/4 S.E. 1/4 = 12.4 Acres
Area in S.W. 1/4 S.E. 1/4 = 0.9 Acres
Area in S.E. 1/4 S.W. 1/4 = 0.6 Acres
Area in N.E. 1/4 S.W. 1/4 = 3.0 Acres

RECEIVED

JAN 13 1995


WATER RESOURCES DEPT
STATE OF OREGON



FINAL PROOF MAP
APPLICATION NO. G-12748
PERMIT NO. G-11612
FOR DOUGLAS DAVID

I, DON DEVLAEINCK, CERTIFIED WATER RIGHT EXAMINER IN THE
STATE OF OREGON, HREBY CERTIFY THE ABOVE FINAL PROOF
MAP WAS PREPARED UNDER MY DIRECT SUPERVISION.

THE PREPARATION OF THIS MAP IS FOR THE PURPOSE OF
IDENTIFYING THE LOCATION OF THE WATER RIGHT ONLY AND
HAS NO INTENT TO PROVIDE DIMENSIONS OR LOCATIONS OF
PROPERTY OWNERSHIP LINES.

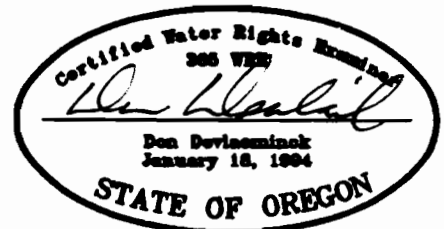

Scale: 1" = 400' | Date: 4/30/95 | Surveyed by: C.V. & T.T. | Drawn by: MMM | Order No. 2771.2

Compass Corporation

6564 S.E. Lake Road

Milwaukie, Oregon 97222

Phone: (503) 653-9093, 222-4652