


T.8S. R. 2W. W.M.

150
1989

PLAT 10000
1989

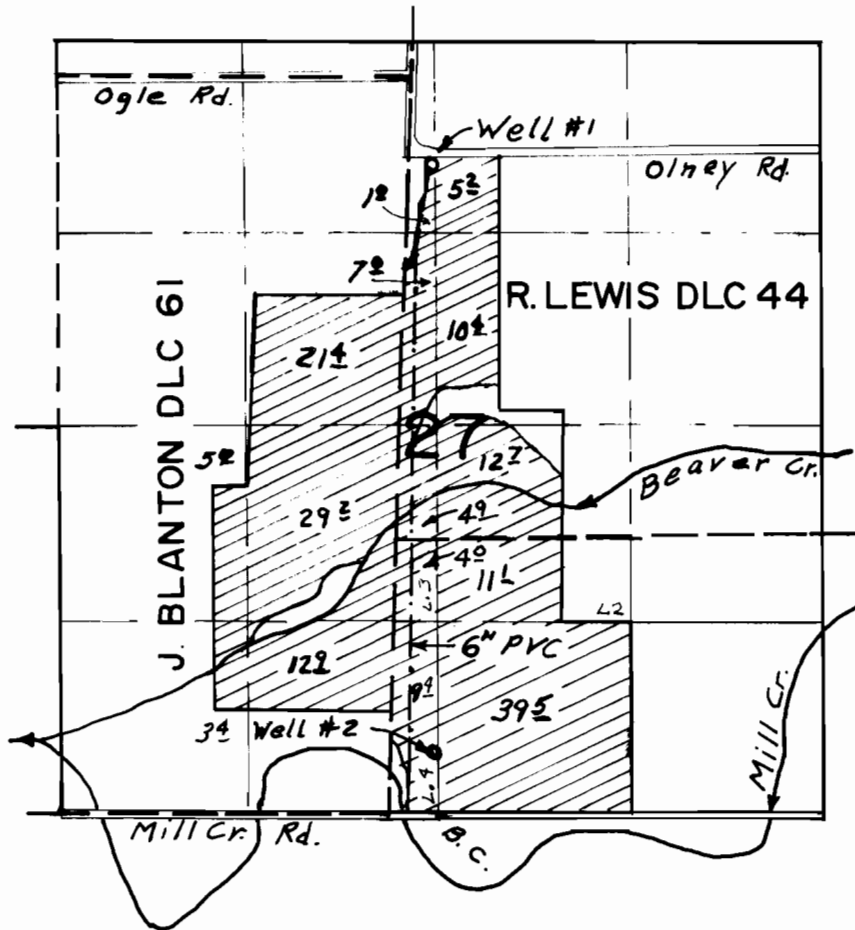


Scale
4" = 1 Mi.

FINAL PROOF SURVEY UNDER

Application No. ~~G-12949~~ Permit No. ~~G-11616~~
IN NAME OF

...PATRICIA...R...MILLER...

Surveyed June 26 1997, by

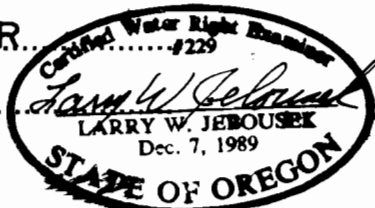

THIS MAP WAS PREPARED FOR THE PURPOSE OF IDENTIFYING THE LOCATION OF A WATER RIGHT ONLY AND IS NOT INTENDED TO PROVIDE LEGAL DIMENSIONS OR LOCATION OF PROPERTY OWNERSHIP LINES.