


SECTION 5 T-1-S-R-3-E, W.M.

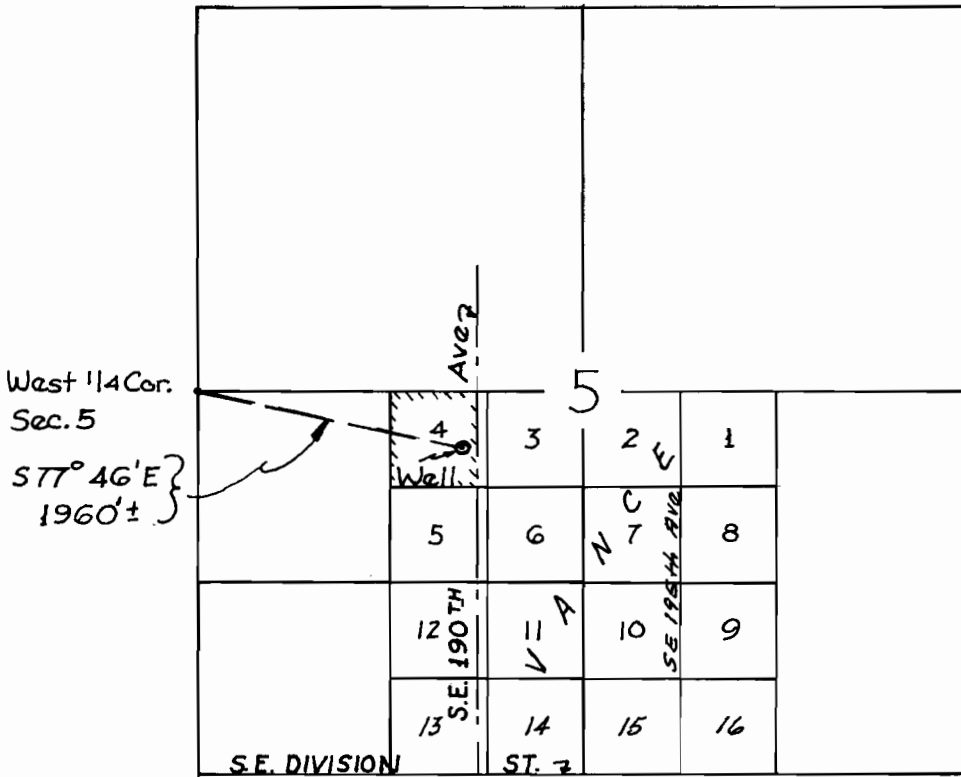

Scale 4" = 1 Mile

Application No. G-1277
Permit No. G-1162