


Township 5 North, Range 28 East, W.M.

N 1/2 of Section 35

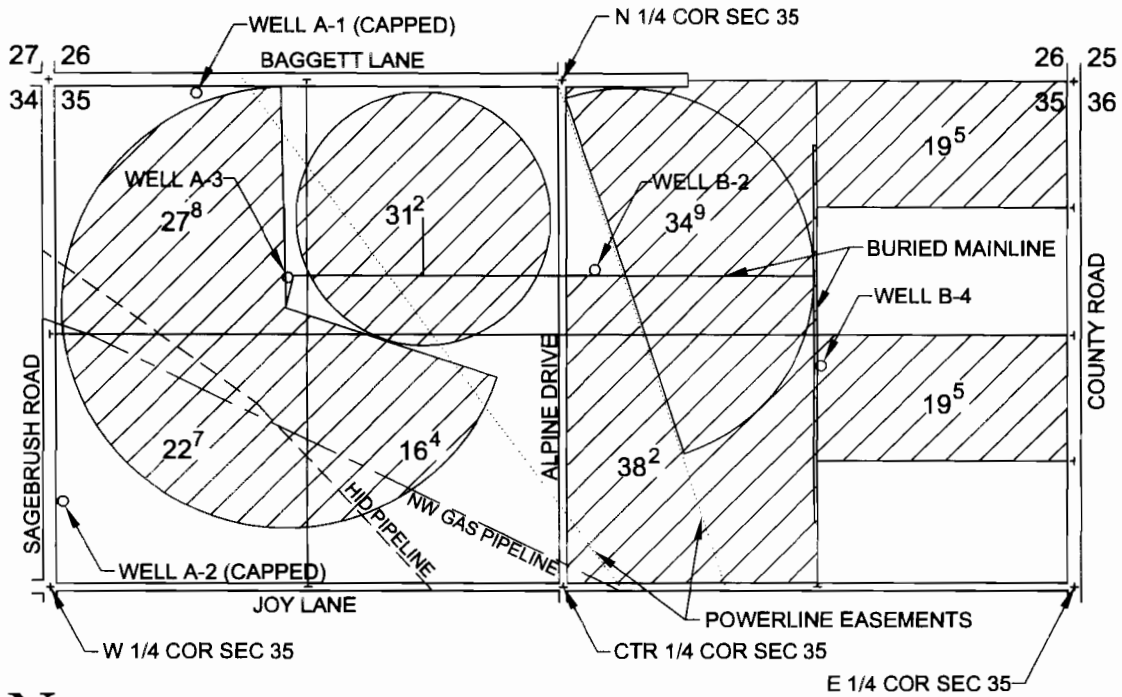


WELL A-1 LOC 70' S & 760' E OF THE NW CORNER OF SECTION 35.
 WELL A-2 LOC 450' N & 70' E OF THE W 1/4 CORNER OF SECTION 35.
 WELL A-3 LOC 1060' S & 1200' E OF THE NW CORNER OF SECTION 35.
 WELL B-2 LOC 1030' S & 150' E OF THE N 1/4 CORNER OF SECTION 35.
 WELL B-4 LOC 1540' S & 1350' W OF THE NE CORNER OF SECTION 35.



SCALE 1" = 1000'

FINAL PROOF SURVEY
 under
 Appl. No. G-12754, Per. No. G-11623
 in name of
SUNRIDGE WATER SYSTEM, INC.
 October 22, 2003

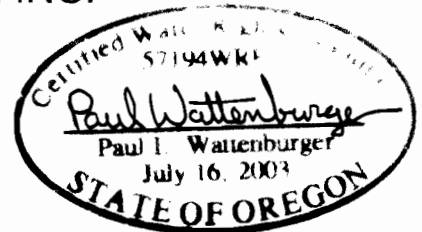

EXPIRES: 6/30/04

RECEIVED

10-30

WATER RESOURCES DEPT.
 SALES OREGON

THIS MAP WAS PREPARED FOR THE PURPOSE OF IDENTIFYING THE LOCATION OF A WATER RIGHT ONLY AND IS NOT INTENDED TO PROVIDE LEGAL DIMENSIONS OR LOCATION OF PROPERTY OWNERSHIP LINES.