


T. 7 S. R. 2 W. WM.

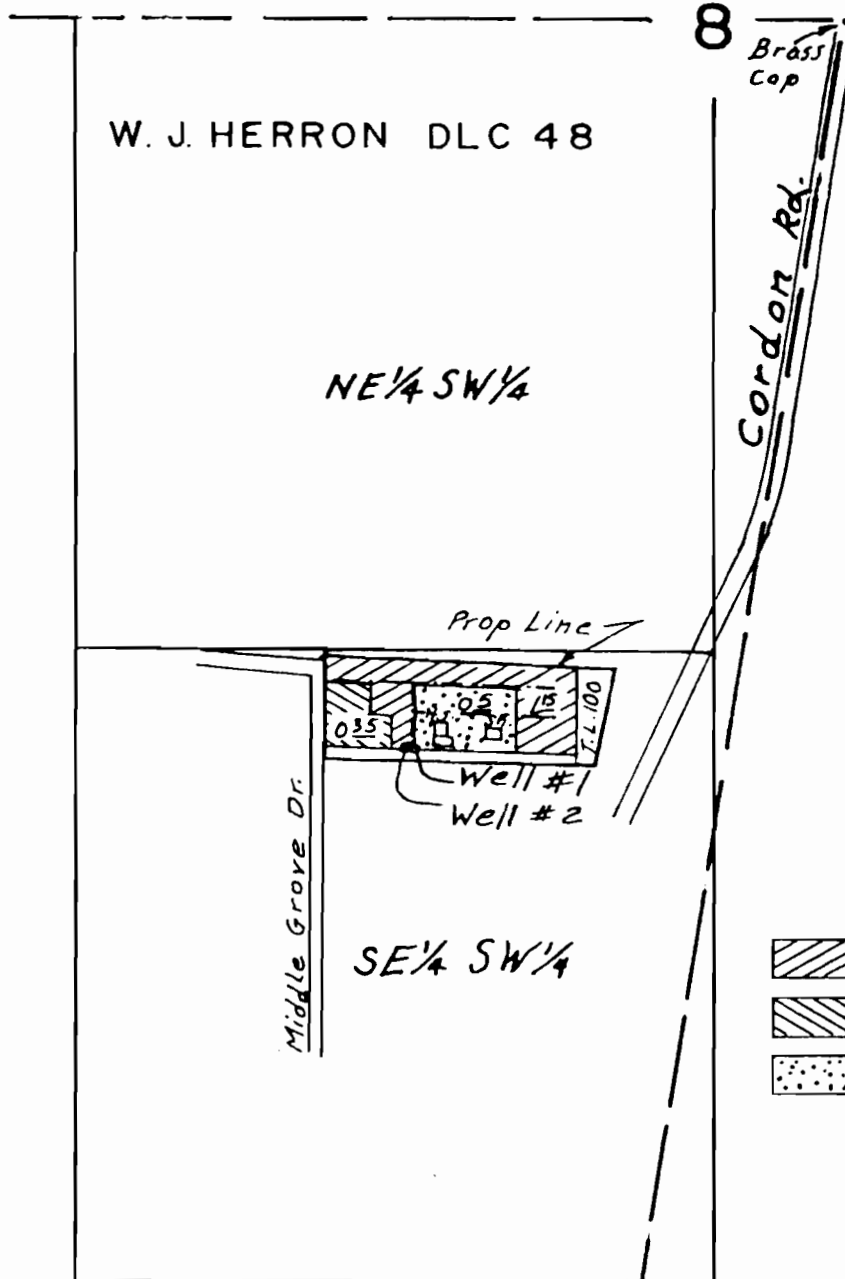


RECEIVED

JUL 5 1996


WATER RESOURCES DEPT
SALEM, OREGON



Scale
1" = 400'

-  Containers
-  In Ground
-  Lawn & Garden

Well #1: 1530' S & 890' W from NE Cor. DLC 48
 Well #2: 1530' S & 915' W " " " " " "

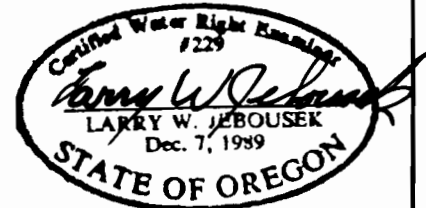

FINAL PROOF SURVEY FOR

Appl. No. G-12516 Per. No. G-11626

TIM DORAN

THIS MAP WAS PREPARED FOR THE
 PURPOSE OF IDENTIFYING THE LOCA-
 TION OF A WATER RIGHT ONLY AND IS
 NOT INTENDED TO PROVIDE LEGAL
 DIMENSIONS OR LOCATION OF PROPER-
 TY OWNERSHIP LINES.

WAC Photo Survey June 11, 1996