


RECEIVED

JAN 22 1992

WATER RESOURCES DEP  
SALEM, OREGON

T.5S.R3W.W.M.

T-6666

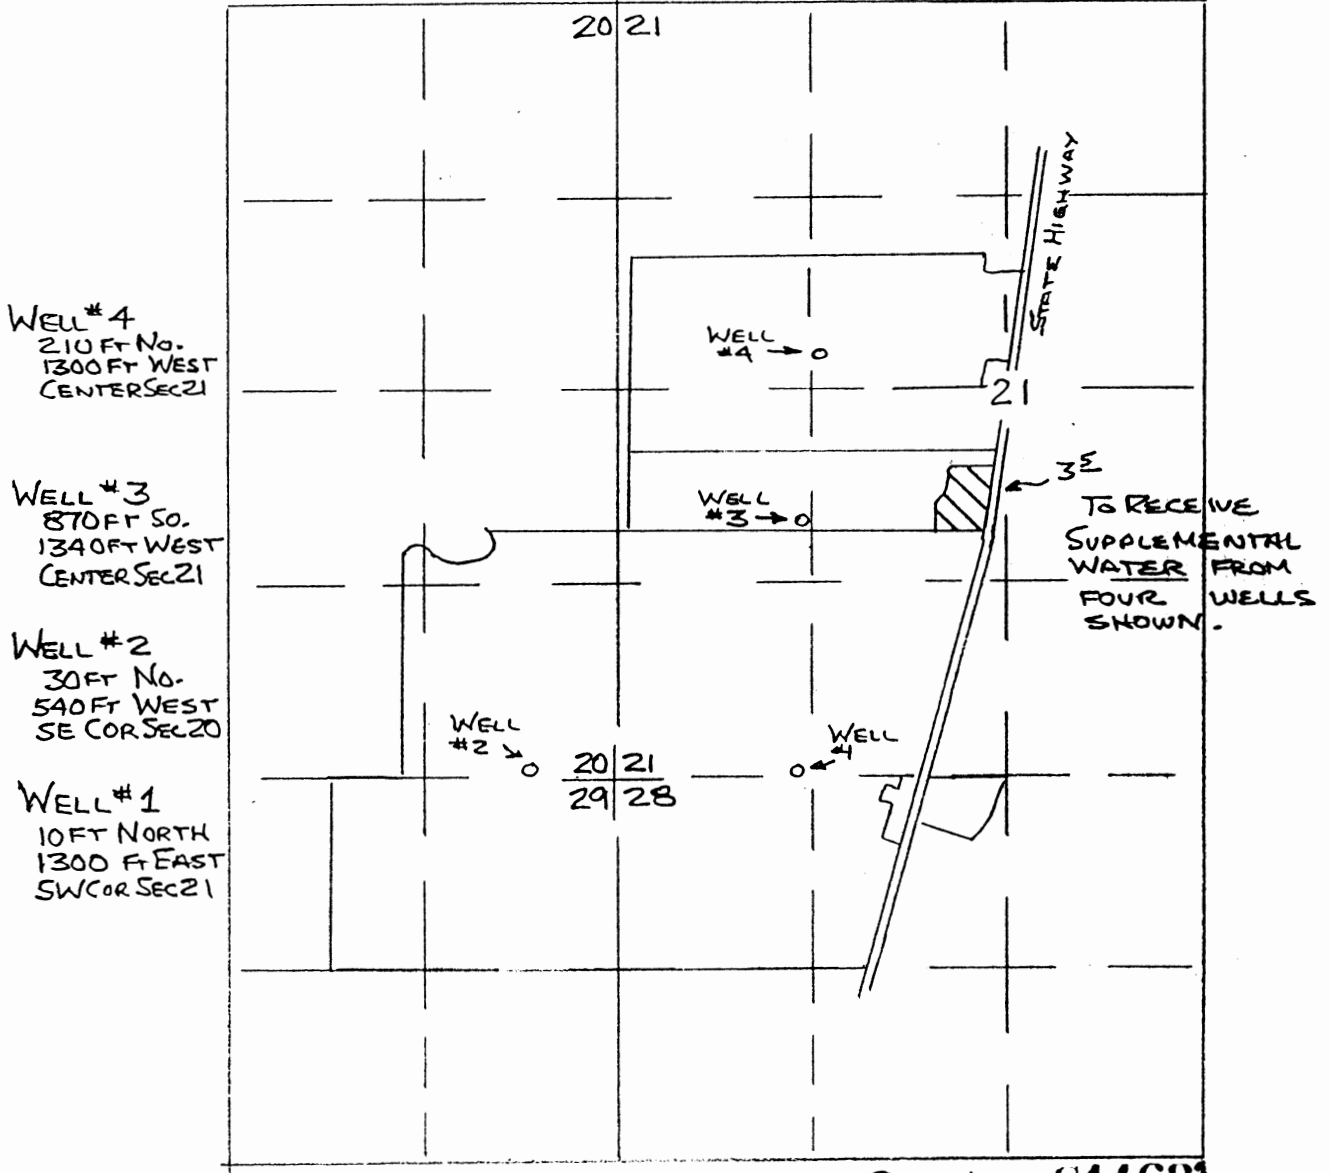

Permit - G11631

NOTE: MAP IS FOR  
PURPOSE OF IDENT-  
IFYING LOCATION OF  
WATER RIGHT AND HAS  
NO INTENT TO DIMEN-  
SION OR LOCATE PROPERTY  
OWNERSHIP LINES.

### APPLICATION MAP

APPLICATION 6-12762

F. EUGENE STOCKHOFF

JAN 18, 1992

SCALE: 1 IN: 1320 FT

