

RECEIVED

DEC 24 1996


T. 7 S., R. 1 W., W.M.

Section 15



Scale 1" = 400'


Surveyed Oct 3, 1996

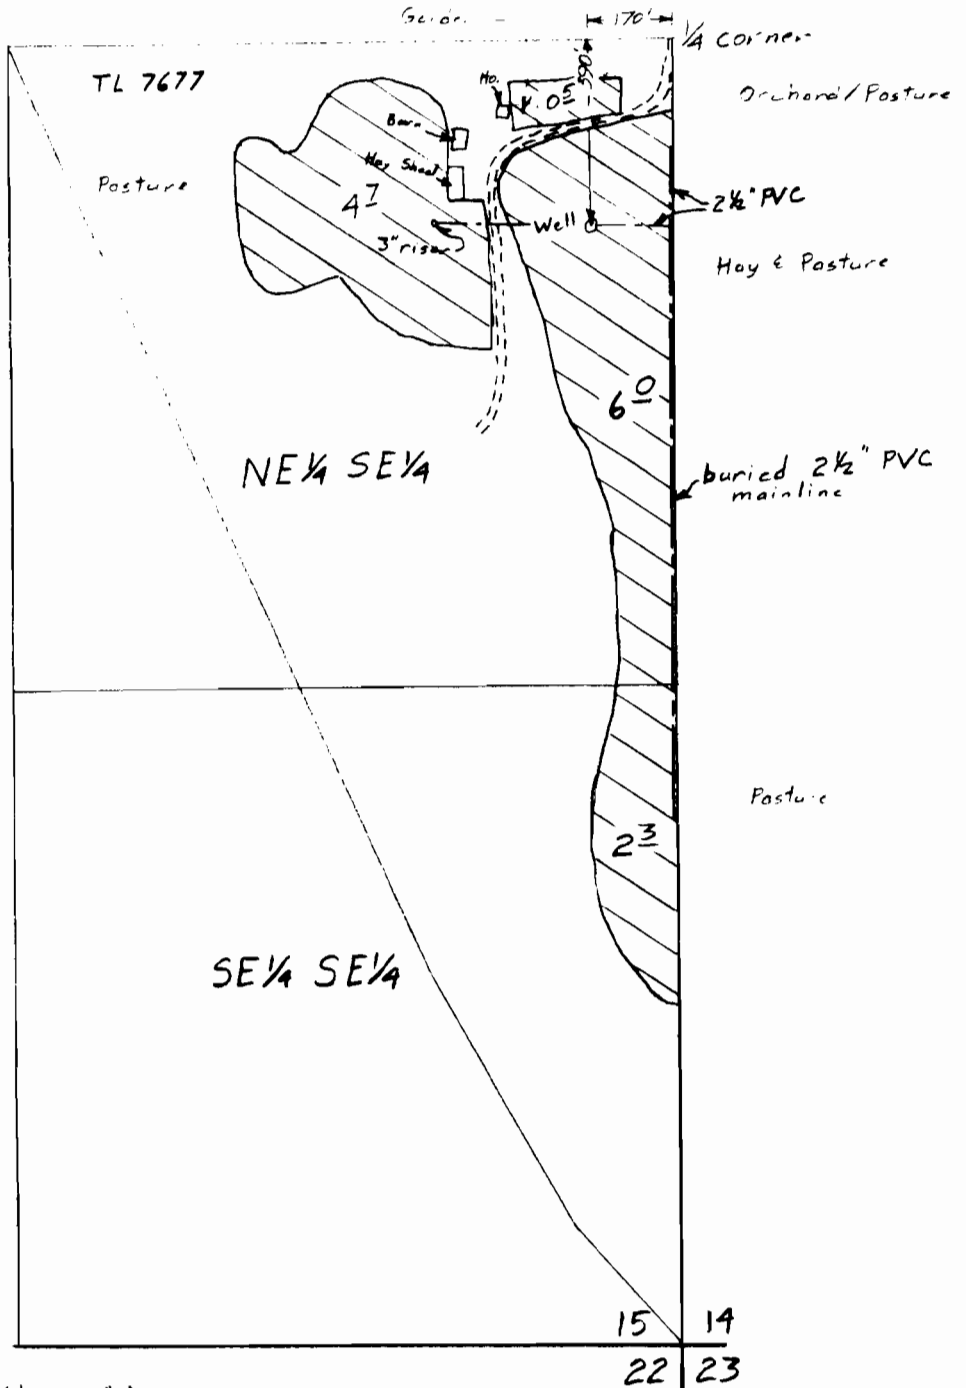

Claim of Beneficial Use Map
for
DONALD M. & EVA S. BEALE

Application G-12506
Permit G-11645

This map is for the purpose of
locating a water right only
and has no intent to provide
legal dimensions or the location
of property lines.

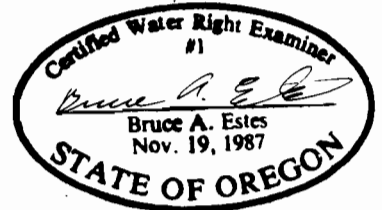

ESTES SURVEYS
 6293 Sunnyview Rd. NE Salem, OR 97305 (503) 585-7593
 60382 Arnold Rd. Bend, OR 97702 (503) 382-7391